

KANSAS

Map No. _____ Sec. 14 Twp. 26 R. 18-W

Well No. 1-Donovan Farm

Stanolind & Elwell Company


_____ Ft. from N. Line

660 Ft. from S. Line

660 Ft. from E. Line

_____ Ft. from W. Line

Elev. 2167

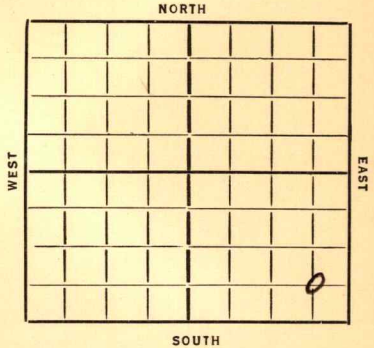

Date	REPORT
1936	
4/1	Location
4/10	ROG.
4/16	Rigging up.
4/23	Surface hole.
4/30	Drlg. 2414'
5/7	Drlg. 3300'.
5/14	Lansing 4037' . T.D. 4055' Set 8".
	Rigging up standard tools.
5/21	Lansing 4048' (Correction)
5/28	Rigging up standard tools.
6/4	--
6/11	Drlg. 4170'.
6/18	Drlg. 4280'.
6/25	Drlg. 4404'.
7/2	Drlg. 4437'.
7/9	4445' fishing 6".
7/16	4460'. U.R. 6".
7/23	Chat 4545-47'. Sand 4557-69'.
	Show of gas.
7/30	TD 4580'. Fishing tools.
8/6--	8/13--8/20--8/27--9/3--9/10--

OVER

- 9/18--9/24--10/1--10/8--10/15--10/22--
 10/29-Did no skid rig trying to drill
 by the seventh whipstock at 4332'
 11/6----- 11/12---
 11/19 Drlg. 4590'. in new hole.
 11/27 5" @ 4590'. Shut down.
 12/3 5" @ 4578'. Clean out.
 12/10 Drlg. 4629'.
 12/17 **Viola 4642'**. Show oil 4643-45'.
 Drlg. 4715'.
 12/24 T. D. 4846'. Shut down.
 12/29 **Simpson 4790'**. **Sil. 4790'**.
 Drlg. 4900'.
 1937
 1/7 Drlg. 4942'.
 1/14 Drlg. 4944' fighting cave.
 1/21 " " " "
 1/28 " " " "
 2/4 " " " "
 2/11 Drlg. 4959'.
 2/17 **Sil. 4872'**.
 T. D. 4984'.

ABANDONED

Map No. 84 Sec. 14 Twp. 26 R. 18 W

Well No. 1-Donovan
Stanolind + Elwell Company

Contractor

FIRST REPORTS

SECTION PLAT

Ft. from N. Line
660 Ft. from S. Line
660 Ft. from E. Line
Ft. from W. Line

			0

Location
Rig up.....
Drilling and Remarks:

RECORD

Cased..... in., ft.
Sand.....
Gas.....
Oil.....
Total Depth.....

PRODUCTION

1st 24 hrs. Nat.....
1st 24 hrs. after shot.....
Gas..... Cu. Ft.
Dry Hole.....
Abandoned.....

Date

ORVAL MANNSCHRECK

4-1-36 192.....

Scout

Edward

Map No. 84 Sec. 14 Twp. 26 R. 18W

Well No. 1 Donovan

Stanford & Elwell Company

Contractor

SECTION PLAT

			0

_____ Ft. from N. Line

660 Ft. from S. Line

660 Ft. from E. Line

_____ Ft. from W. Line

ABANDONED

Location _____

Rig up _____

Drilling and Remarks:

Sil 4872.

RECORD

Cased _____ in., _____ ft.

Sand _____

Gas _____

Oil _____

Total Depth 4984

PRODUCTION

1st 24 hrs. Nat. _____

1st 24 hrs. after shot _____

Gas _____ Cu. Ft.

Dry Hole

Abandoned

Date

FEB 17 1937 19

S. J. LEWIS Scout