


Section 1 Township 26 Range 18-W

Well No. #1 Newsom

Company Falcon - Seaboard & Darby

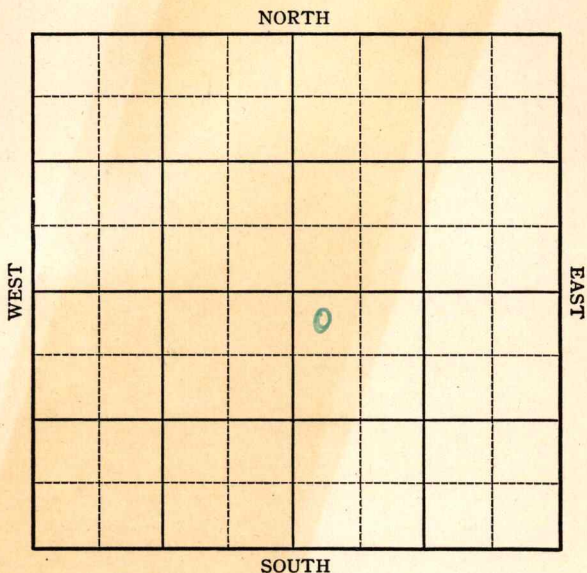



Edwards **KANSAS**

Map No. H-84 Sec. 1 Twp. 26 R. 18W

Well No. 1 Newsom

Falcon-Seaboard & Darby Company

**FIRST REPORT**

Contractor

NW SE

**SECTION PLAT**

		o	

330 Ft. from N. Line

\_\_\_\_\_ Ft. from S. Line

\_\_\_\_\_ Ft. from E. Line

330 Ft. from W. Line

**WILDCAT**

Location \_\_\_\_\_

Rig up \_\_\_\_\_

Drilling and Remarks:

Derrick

**RECORD**

Cased \_\_\_\_\_ in., \_\_\_\_\_ ft.

Sand \_\_\_\_\_

Gas \_\_\_\_\_

Oil \_\_\_\_\_

Total Depth \_\_\_\_\_

**PRODUCTION**

1st 24 hrs. Nat. \_\_\_\_\_

1st 24 hrs. after shot \_\_\_\_\_

Gas \_\_\_\_\_ Cu. Ft.

Dry Hole \_\_\_\_\_

Abandoned \_\_\_\_\_

Date

OCT 29 1941 19

S. J. LEWIS Scout

Map No. 84 Sec. 1 Twp. 26 R. 18W

Well No. 1 Newsom

Falcon-Seaboard & Darby Company

**ABANDONED**

Contractor

NW SE

SECTION PLAT

330 Ft. from N. Line

\_\_\_\_\_ Ft. from S. Line

\_\_\_\_\_ Ft. from E. Line

330 Ft. from W. Line

		0	

WILDCAT

RECORD

Location \_\_\_\_\_

Cased \_\_\_\_\_ in., \_\_\_\_\_ ft.

Rig up \_\_\_\_\_

Sand \_\_\_\_\_

Drilling and Remarks:

Gas \_\_\_\_\_

Oil \_\_\_\_\_

Total Depth 4983

*Cr 4866*

PRODUCTION

*No shows.*

1st 24 hrs. Nat. \_\_\_\_\_

1st 24 hrs. after shot \_\_\_\_\_

Gas \_\_\_\_\_ Cu. Ft.

Dry Hole \_\_\_\_\_

Abandoned \_\_\_\_\_

Date

DEC 10 1941

19

S. J. LEWIS Scout