
KANSAS
FORM 51 5M 1-42 PETROL

Edwards

Section 5 Township 26 Range 18-W

Well No. #1 Miller

Company Broderick & Gordon

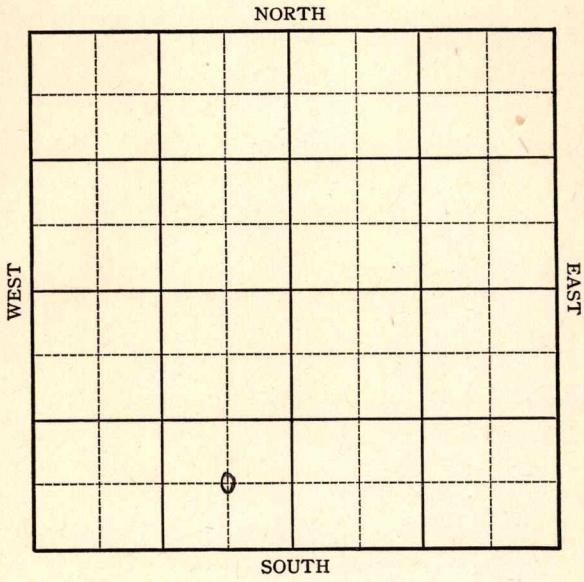

FORM 252-A
5M 9-42 GASS


KANSAS

Edwards

Sec. 5 Twp. 26 R. 18-W

Well No. #1 Miller Farm

Broderick & Gordon Company

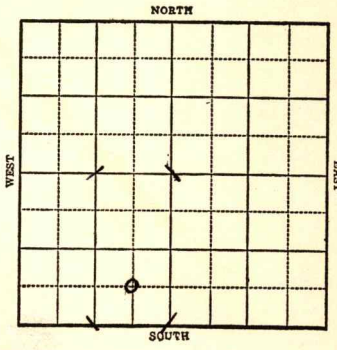

_____ Ft. from N. Line

660 Ft. from S. Line

660 Ft. from E. Line

_____ Ft. from W. Line

Elev. 2190

1943	REPORT
5/5	Derrick Stanolind farmout
5/12	"
5/19	"
5/26	10" @ 423 Drlg. 2550'
6/2	Drlg. 3590'
6/9	Lans 4050 Drlg. 4370
6/16	Congl. 4628 Drlg. 4751'
6/23	Miss. 4748 Viola 4805 Simp. 4971 Arb. 5059 T.D. 5085'

ABANDONED

Form 26 200 Bks. 5-42 Petrol

KANSAS

Edwards

Map No. 84 Sec. 5 Twp. 26 R. 18W

Well No. 1 Miller


Broderick & Gordon Company

FIRST REPORT

Contractor

C SE SW

SECTION PLAT

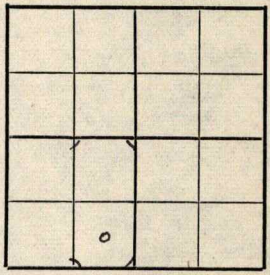

Ft. from N. Line

660 Ft. from S. Line

660 Ft. from E. Line

Ft. from W. Line

WILDCAT

Location

Rig up

Drilling and Remarks:

Stanolind
farmout

Derrick

RECORD

Cased in., ft.

Sand

Gas

Oil

Total Depth

PRODUCTION

1st 24 hrs. Nat.

1st 24 hrs. after shot

Gas Cu. Ft.

Dry Hole

Abandoned

Date

MAY 5 1943 19

S. J. LEWIS Scout

Form 26 200 Bks 5-42 Petrol **Edwards**

KANSAS

Map No. 84 Sec. 5 Twp. 26 R. 18W


Well No. 1 Miller

Broderick & Gordon Company

ABANDONED Contractor

C SE SW

SECTION PLAT

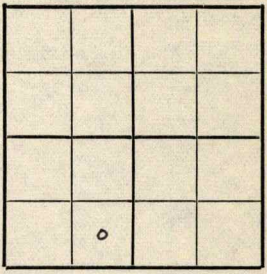

____ Ft. from N. Line

660 Ft. from S. Line

660 Ft. from E. Line

____ Ft. from W. Line

WILDCAT

Location

Rig up

Drilling and Remarks:

Miss 4748
Viola 4805
Simp 4971
TD 5085

RECORD

Cased ____ in., ____ ft.

Sand

Gas

Oil

Total Depth 5085

PRODUCTION

1st 24 hrs. Nat.

1st 24 hrs. after shot

Gas ____ Cu. Ft.

Dry Hole

Abandoned

Date

JUN 2 3 1943 19

S. J. LEWIS Scout