

DX 78-1


Edwards

KANSAS

Section 11 Township 26 Range 18 W

Well No. # 1 Newsom "B"

Company G-M-R Oil

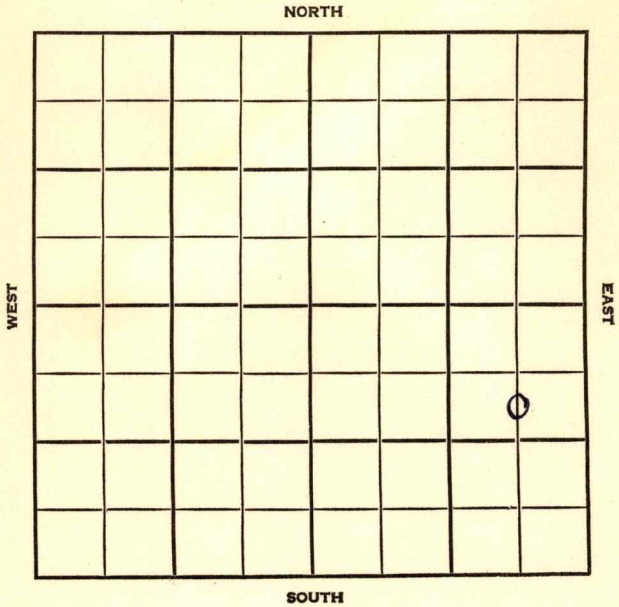


SEC.	TWP.	R.
11	26	18W
WELL NO.		
#1 Newsom "B"		FARM
COMPANY		
G-M-R Oil		
CONTRACTOR		

990 _____ Ft. from N. Line

_____ Ft. from S. Line

660 _____ Ft. from E. Line

_____ Ft. from W. Line

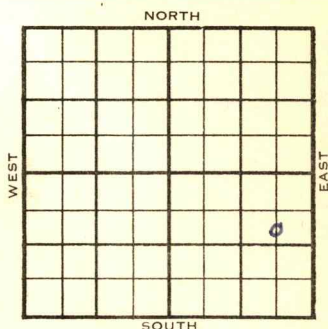C S $\frac{1}{2}$ NE SE

1954

ELEVATION

2162'

REPORT

10/13

Spud 10-13-54

M I R

12/1

Spud 10-13-54 D & A TD 4824
 8-5/8" @ 320 Heeb 3875 Br lime
 4000' Lans 4011

DST 4191-4201 open 1 hr rec 95'
 muddy SW 470# Kh. 4526

DST 4529-47 open 1 hr gas in 40 min.
 rec 390' gas, 210' GCM, 90' GCM SW
 90' SO & HGCM, 1110#

DST 4570-4600 open 1 hr gas in 20
 min, rec 210' GCM 90# Chert 4570

Viola 4618

DST 4611-50 open 1 hr rec 30' mud
 540# Simp. 4710

DST 4703-42 open 1 hr rec 35' mud
 1125# Arb. 4802 TD 4824

5" @ 4660 CO to 4623 27/4588-98

28/4571-78 300 M-A S/AW

40/4532-42 70 GOPH 1,500,000 CFG

Frac 1,500,000 CFG 20/4193-98

SO & G 4 BWPH D & A

ABANDONED

County **Edwards** State **Kansas**

Sec. **11** (Blk. Twp.) **26** (Sur. Rge.) **18W** Map No.

Operator **G-M-R Oil**

Well No. **1** Farm **Newsom "B"**

Elev. Location **C S $\frac{1}{2}$ NE SE**

990 Ft. From **N** Line **SE**

660 Ft. From **E** Line Quarter

1st. Report **OCT 13 1954**

Completion

Remarks

Spudding Date **10-13-54**

Drlg. Data

M I R

FABEN GILSTRAP

County Edwards State Kansas

Sec. 11 (Blk. Twp.) 26 (Sur. Rge.) 18W Map No.

Operator G-M-R Oil

Well No. 1 Farm Newsom "B"

Elev. 2162 Location C S $\frac{1}{2}$ NE SE



990 Ft. From N Line SE

660 Ft. From E Line Quarter

1st. Report

Completion DEC 1 1954

Remarks

Spudding Date 10-13-54

Drlg. Data D & A TD 4824

8 5/8" @ 320 Heeb. 3875 Br. lime 4000

Lans. 4011 DST 4191-4201 open 1 hr.

Rec. 95' muddy sw 470# Kh. 4526

DST 4529-47 open 1 hr. gas in 40 min.

Rec. 390' gas 210' gcm 90' gcm sw

90' so & hgcm 1110# DST 4570-4600

open 1 hr. gas in 20 min. Rec. 210'

gcm 90# Chert 4570 Viola 4618

DST 4611-50 open 1 hr. Rec. 30' mud

540# Simp. 4710 DST 4703-42 open 1 hr.

Rec. 35' mud 1125# Arb. 4802

TD 4824 5" @ 4660 CO to 4623

27/ 4588-98 28/ 4571-78 300 M-A

S/ AW 40/ 4532-42 70 goph 1,500,000 cf

FABEN GILSTRAP

Drlg. Data

frac 1,500,000 cfg 20/ 4193-98

SO & G 4 bwph

D & A

1954

DEC 7

[Handwritten signature]

