

KANSAS


FORM 51 5M 10-41 PETROL

Edwards

Section 11 Township 26 Range 18-W

Well No. #1 Walter Newson

Company Stanolind

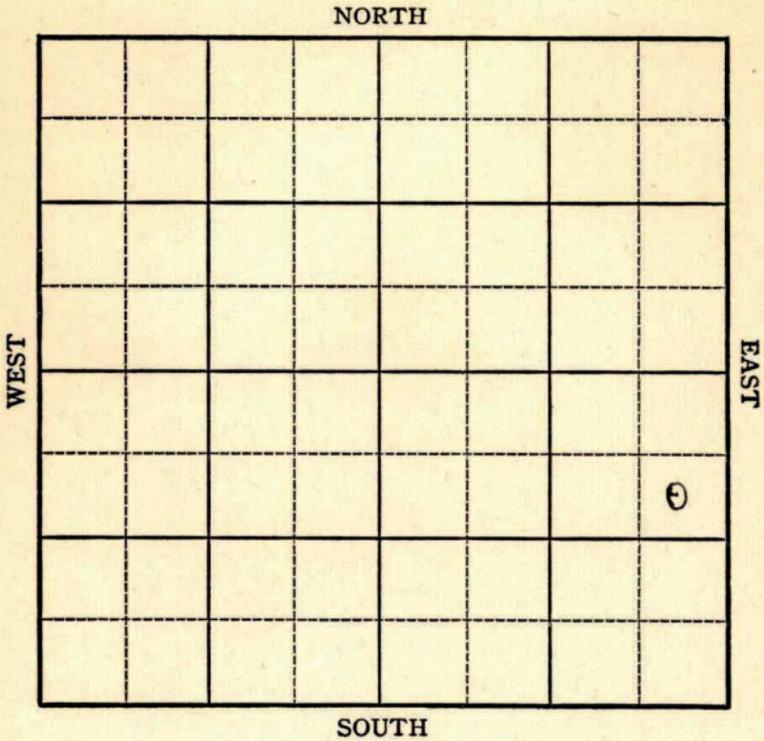

KANSAS

Edwards

Sec. 11 Twp. 26 R. 18-W

Well No. #1 Walter Newsom Farm

Stanolind Company

Wildcat


990 Ft. from N. Line

_____ Ft. from S. Line

330 Ft. from E. Line

_____ Ft. from W. Line

Elev. 2165

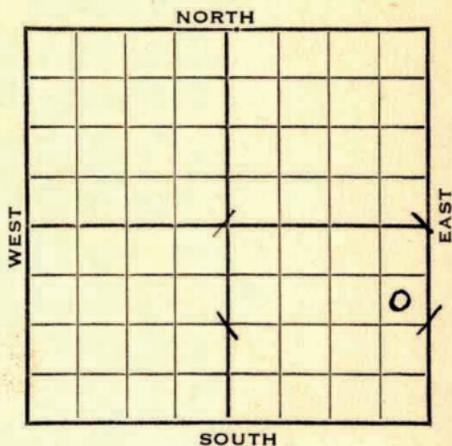

1943

REPORT

2/24 Derrick.

3/3 8" Casing set 270 WOC.

3/10 Drlg. 2550'

3/17 Drlg. 3625'

3/24 Drlg. 4320'

4/14 **Arb. 4808**
T.D. 4845'
No shows.

ABANDONED

Edwards

KANSAS
Map No. 84 Sec. 11 Twp. 26 R. 18W

Well No. 1 Walter Newsom

Stanolind Company

FIRST REPORT Contractor

SE NE SE


SECTION PLAT

990 Ft. from N. Line

_____ Ft. from S. Line

330 Ft. from E. Line

_____ Ft. from W. Line

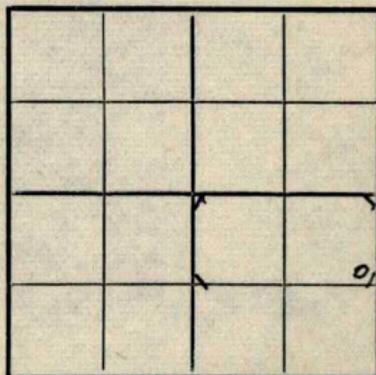

WILDCAT

Location _____

Rig up _____

Drilling and Remarks:

Derrick

RECORD

Cased _____ in., _____ ft.

Sand _____

Gas _____

Oil _____

Total Depth _____

PRODUCTION

1st 24 hrs. Nat. _____

1st 24 hrs. after shot _____

Gas _____ Cu. Ft.

Dry Hole _____

Abandoned _____

Date

FEB 24 1943 19

S. J. LEWIS Scout

Edwards

KANSAS

Map No. 84 Sec. 11 Twp. 26 R. 18W

Well No. 1 Walter Newsom

Stanolind Company

ABANDONED Contractor

SE NE SE

SECTION PLAT

990 Ft. from N. Line

_____ Ft. from S. Line

330 Ft. from E. Line

_____ Ft. from W. Line

			o

WIIDCAT

Location _____

Rig up _____

Drilling and Remarks:

Cor 4808

No show

RECORD

Cased _____ in., _____ ft.

Sand _____

Gas _____

Oil _____

Total Depth 484.5

PRODUCTION

1st 24 hrs. Nat. _____

1st 24 hrs. after shot _____

Gas _____ Cu. Ft.

Dry Hole _____

Abandoned _____

Date

APR 14 1943 19

S. J. LEWIS Scout