


Section 13 Township 26 Range 18W

Well No. #1 Madden

Company National Assoc. Pet.

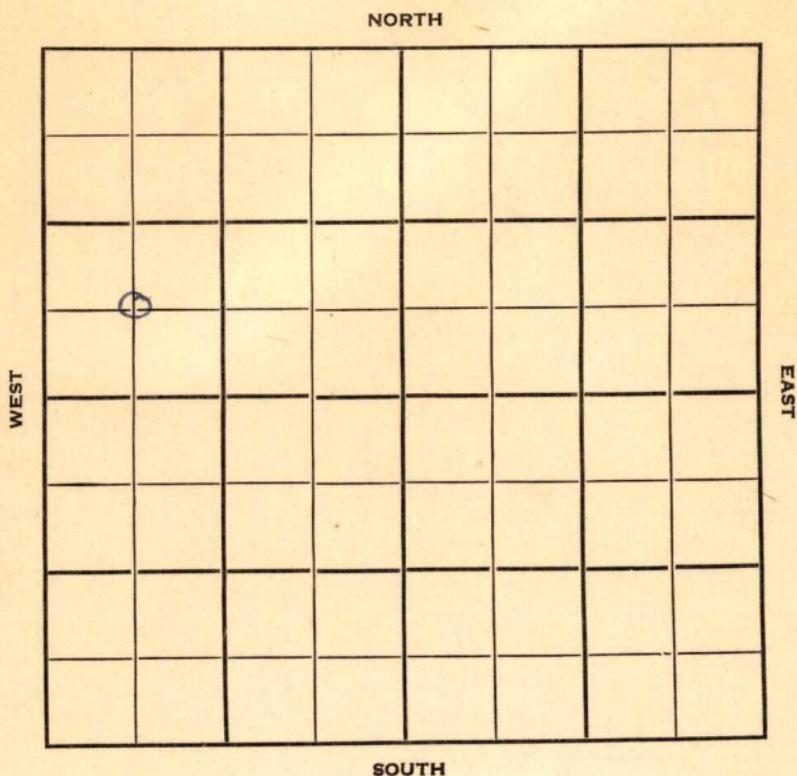

Sec. 13 Twp. 26 R. 18 W

Well No. # 1 Madden Farm

National Assoc. Pet. Company

Wildcat Contractor


Ft. from N. Line

660 Ft. from S. Line

Ft. from E. Line

660 Ft. from W. Line

C SW NW

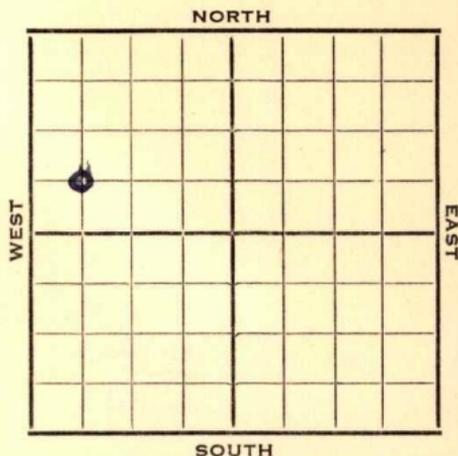

Elev. 2162' REPORT

1952

- 11/5 Spud 10-26-52
8" @ 308 Pipe stuck @ 2905'
- 11/12 "
- 11/20 Pipe stuck
- 11/26 Spud 10-26-52
D&A
TD 4966'
8" @ 308
Top. 3516, Heeb 3886, Br lime
4014, Lans 4045
DST 4072-86, opn 1 hr., rec. 72'
fluid & SS0 905#
Cong. 4542
DS¹ 4541-65, opn 1½ hr., rec.
20' mud 0#
Miss 4596, Viola 4565
DST 4657-81, opn ¾ hrs.,
rec. 65' mud, 1500#
DST 4657-81'? opn 1 hr., rec.
10' mud 0#
Simp 4724, Arb 4810
TD 4966'
D&A

ABANDONED


County **Edwards** State **Kansas**

Sec. **13** (Blk. Twp.) **26** (Sur. Rge.) **18W** Map No.

Operator **National Assoc. Pet.**

Well No. **1** Farm **Madden**

Elev. Location **C SW NW**

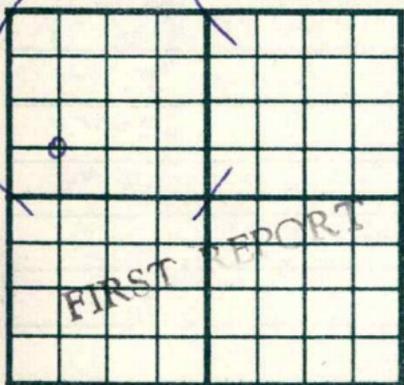

660 Ft. From **S** Line **NW**

660 Ft. From **W** Line Quarter

Ist. Report **NOV 5 1952**

Completion

Remarks

Spudding Date **10-26-52**

Drlg. Data **Wildcat**

8" @ 308 pipe stuck @ 2905


County Edwards State Kansas

Sec. 13 (Blk. Twp.) 26 (Sur. Rge.) 18W Map No.

Operator National Assoc. Pet.

Well No. 1 Farm Madden

Elev. 2162 Location C SW NW

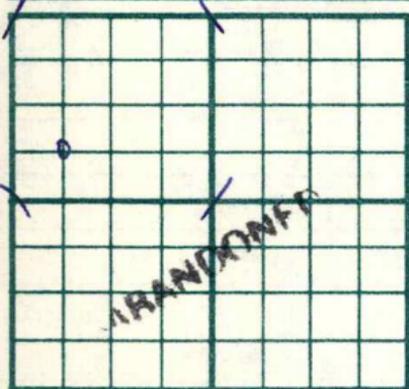

660 Ft. From S Line NW

660 Ft. From W Line Quarter

1st. Report

Completion NOV 26 1952

Remarks Wildcat

Spudding Date 10-26-52

Drilg. Data D & A TD 4966

8" @ 308 Top. 3516 Heeb. 3886

Br. lime 4014 Lans. 4045 DST 4072-86

open 1 hr. Rec. 72' fluid & SSO 905#

Cong. 4542 DST 4541-65 open 1 1/2 hr.

Rec. 20' mud O# Miss. 4596

Viola 4656 DST 4657-81 open 3/4 hr.

Rec. 65' mud 1500# DST 4657-8k open

1 hr. Rec. 10' mud O# Simp. 4724

Arb. 4810 TD 4966

D & A

J. G. McGEHEE