


Section 23 Township 26S Range 18W

Well No. 1 Ben Berdewick Est

Company Carter Oil Co.

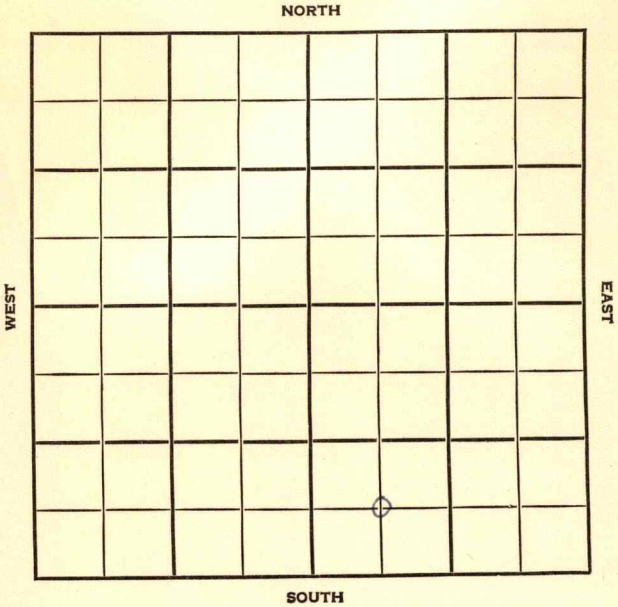

Edwards

KANSAS

SEC. 23	TWP. 26S	R. 18W
------------	-------------	-----------

WELL NO.

#1 Ben Bordewick Est.

FARM

COMPANY

Carter Oil Co.

CONTRACTOR

Adkins


W.C.

_____ Ft. from N. Line

_____ Ft. from S. Line

_____ Ft. from E. Line

_____ Ft. from W. Line

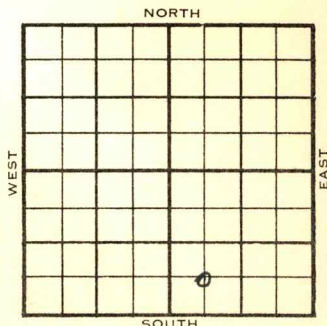

FIRST REPORT

	ELEVATION	REPORT		
1955	2165'			
7/13	Spud 7/10/55			
	D 210			
8/3	8 5/8" @359/300 DSt 4524-46 open 1 1/2 hr			
	gas in 66 min. Rec. 28' wgcm 1454/30"			
	TD 4795 D&A			
	H.	3872	3876	1711
	Tr.		3891	1726
	Dg.		3905	1740
	Bl	4011	4008	1843
	L.	4017	4018	1853
	BKC		4378	2211
	M.	4540	4540	2375
	V.	4622	4610	2445
	Viola Dol		4619	2454
	S.		4668	2503
	A.	4757	4756	2591
	TD	4795		

ABANDONED

Farm Name Ben Bordewick Est. No. 1

TOPS	DEPTH	LOG	DATUM
Anh.			
Tp.			
H.			
Tr.			
Dg.			
Bl.			
L.			
K.C.			
B.K.C.			
Ce.			
C.			
M.			
M.			
K.			
Mz.			
Mq.			
V.			
S.			
S.			
A			
R.			
Pe.			
G.			
T.D.			

Pool

W.C.

JUL 19 '55

JUL 15
FIRST REPORT

Date Comm. spd 7/10/55 D 210

Use:

No.

Sec.



County Edwards Elev. 2165
 Sec. 23 Twp. 2 6 Rge. 18W
 Company Carter Oil
 Farm Name Ben Bordewick Est. No. 1

TOPS	DEPTH	LOG	DATUM
Anh.			
Tr.			
H.	<u>3872</u>	<u>3876</u>	<u>1711</u>
Tr.		<u>3891</u>	<u>1726</u>
Dg.		<u>3905</u>	<u>1748</u>
Bl.	<u>4011</u>	<u>4008</u>	<u>1843</u>
L.	<u>4017</u>	<u>4018</u>	<u>1853</u>
K.C.			
B.K.C.		<u>4376</u>	<u>2211</u>
Ce.			
C.			
M.	<u>4540</u>	<u>4540</u>	<u>2375</u>
M.			
K.			
Mz.			
Mq.			
V.	<u>4622</u>	<u>4610</u>	<u>2445</u>
S. <u>Viol 2 Dol</u>		<u>4619</u>	<u>2454</u>
S.		<u>4668</u>	<u>2503</u>
A.	<u>4757</u>	<u>4756</u>	<u>2591</u>
R.			
PE.			
G.			
TD.	<u>4795</u>		

Loc. in Sec. _____

C SW SE

Geol. _____

Contr. _____

Adkins

Pool _____

Wildcat

ABANDONED

Date Comm. 7-10-55

AUG 3 1955

8 5/8" @ 359/300 DST 4524-46 open

1 1/2 hr. gas in 66 min. Rec. 28' wgcm

1454/30" TD 4795

D & A