


Edwards

KANSAS

SECTION 34 TOWNSHIP 26S RANGE 18W

WELL NO. #1 Meyers

COMPANY L. C. Smitherman

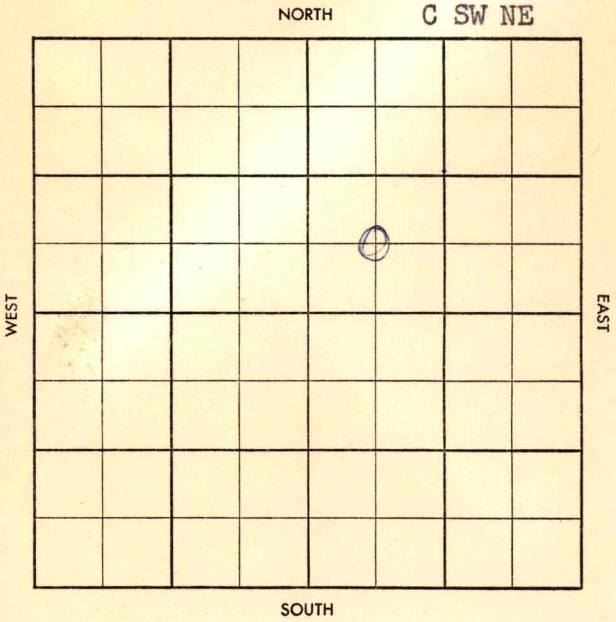


WILDCAT

S-513-B

County Edwards Elev. _____
 Sec. 34 Twp. 26 Rge. 18W
 Company L. C. Smitherman
 Farm Name Meyers No. 1

TOPS	DEPTH	LOG	DATUM	Loc. in Sec. _____
Anh. _____				<u>C SW NE</u>
Tp. _____				
H. _____				
Tr. _____				
Dg. _____				
B.L. _____				
L. _____				
K.C. _____				Geol. _____
B.K.C. _____				Contr. _____
Ce. _____				<u>Smitherman #2</u>
C. _____				
M. _____				Pool _____
M. _____				<u>Wildcat 3/4 M</u>
K. _____				
Mz. _____				
Mq. _____				
V. _____				
S. _____				
S. _____				
A. _____				
R. _____				
Pf. _____				
G. _____				
T.D. _____				

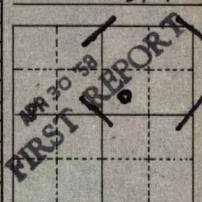

Date Comm. _____ (Carter & Continental
 Location. Simp Sd test. Ac & DHM)

Twp. ~~Pool~~Co. ~~Facet~~

S-513-B

County Edwards Elev. 2180 DE 2123 KB
 Sec. 34 Twp. 26 Rge. 18W
 Company L. C. Smitherman
 Farm Name Meyers No. 1

TOPS	DEPTH	LOG	DATUM	Loc. in Sec.
Anh.				C SW NE
Tp.				
H.	<u>3952</u>			
Tr.	<u>3970</u>			
Dg.	<u>3990</u>			
B.L.	<u>4092</u>			
L.	<u>4099</u>			
K.C.				Geol.
B.K.C.	<u>4482</u>			Contr.
Ce.				
C.				Smitherman #2
M.	<u>4630</u>			Pool
M.				Wildcat 3/4 Mi
K. <u>sd</u>	<u>4668</u>			
Mz.				
Mq.				
V.				
S.	<u>4894</u>			
S.				
A.				
R.				
Pf.				
G.				
T.D.	<u>4918</u>			

MAY 28 '58

ABANDONED

Date Comm. 5-1-58 (Carter & Continental
 Location. Simp Sd test. Ac & DHM)

MAY 7 '58 8' 385/250 Ø 2572
 MAY 14 '58 Ø 4120 MAY 21 '58 Ø 4735
 MAY 28 '58 log

D6A