


Edwards

KANSAS

SECTION 25 TOWNSHIP 26 RANGE 18W

WELL NO. #1 Chadd

COMPANY Ambassador Oil

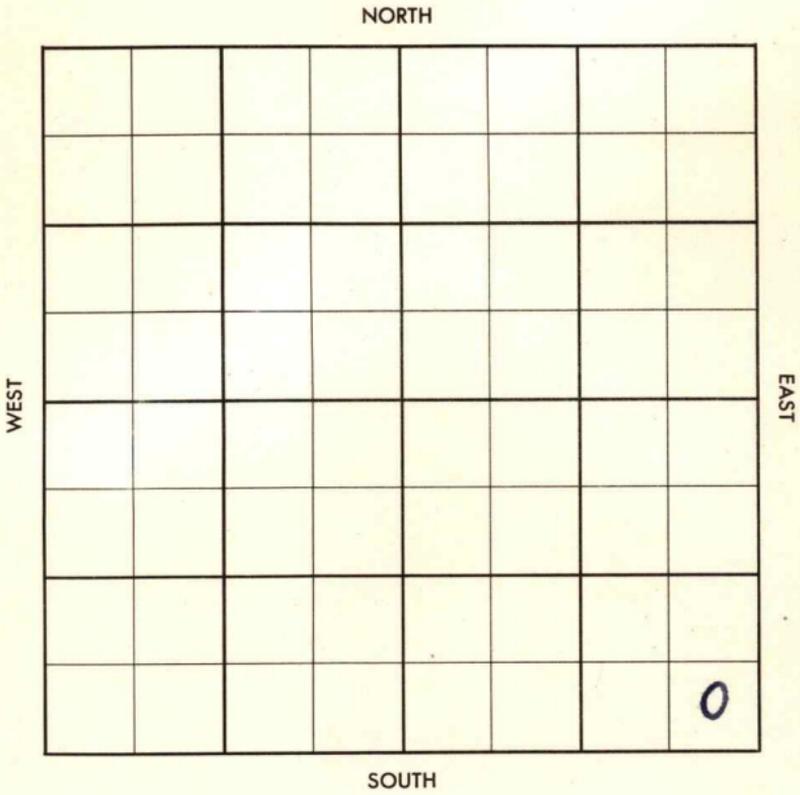

SEC. 25	TWP. 26	R. 18W
------------	------------	-----------

WELL NO. #1 Chadd FARM

COMPANY  
Ambassador Oil

CONTRACTOR  
Peel


**WILDCAT**

\_\_\_\_\_ Ft. from N. Line

\_\_\_\_\_ Ft. from S. Line

\_\_\_\_\_ Ft. from E. Line

\_\_\_\_\_ Ft. from W. Line

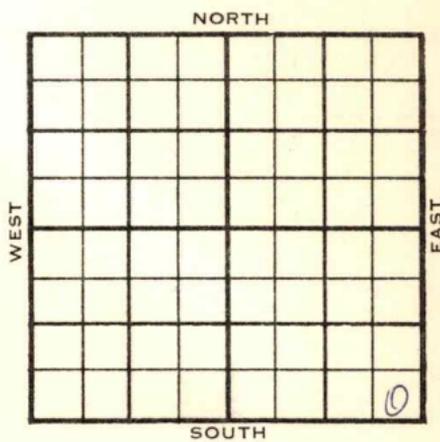

SE SE SE

1956	ELEVATION	REPORT
------	-----------	--------

**2151**

4-25 Comm. 4-24-56  
8" @ 307  
Drlg. 2245

5-23 Twist off @ 3227  
DST 4607-40 op 1 hr. gas to surface in  
5 min, rec. 25' GCM / 120' GCMW / 180'  
CSW, BHP 1230/20"

D & A

H.	3953	3954
BL.	4090	<b>4092</b>
L.	4102	4104
BKC	4478	4472
M.	4616	4618
K.	4677	4679
K.Sd.	4711	4712-51
V.		4772
S.		4937
A.		5026


TD 5051'

**ABANDONED**

County Edwards Elev. 2151  
 Sec. 25 Twp. 26 Rge. 18W  
 Company Ambassador Oil  
 Farm Name Chadd No. 1

	TOPS	DEPTH	LOG	DATUM
Anh.				
Tr.				
Dg.				
Bl.				
L.				
K.C.				
B.K.C.				
Ce.				
C.				
M.				
M.				
K.				
Mr.	<u>K 3d</u>	<u>4711</u>	<u>4712-91</u>	
Ma.			<u>4772</u>	
V.			<u>4937</u>	
S.				
S.			<u>5026</u>	
A.				
R.				
PE.				
G.				
TD.		<u>5051</u>		

Loc. in Sec. SE SE SE  
 Geol. \_\_\_\_\_  
 Contr. \_\_\_\_\_  
 Pool Peel  
Wildcat

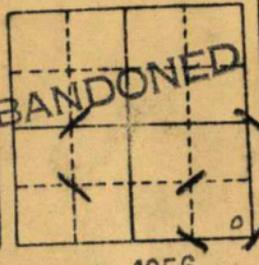

Date Comm. 4-24-56 MAY 23 1956  
8" @ 307 drlg. 2245 MAY 2 '56 TWIST  
OFF @ 3227 MAY 9 '56 Ø 4374 MAY 18 '56  
DST 4607-40 1hr 9 to 5 5" TSTM  
acc 25' GCM + 120' GCMW +  
180' CSW BHP 1230/20"  
Ø 4915 MAY 23 '56  
D&A.

County Edwards Elev. \_\_\_\_\_  
 Sec. 25 Twp. 26 Rge. 18W  
 Company Ambassador Oil  
 Farm Name Chadd No. 1

TOPS	DEPTH	LOG	DATUM	Loc. in Sec.
Anh.				SE SE SE
Tp.				
H.				
Tr.				
Dg.				
Bl.				
L.				
K.C.				Geol. _____
B.K.C.				Contr. _____
Ce.				Pool <u>Peel</u>
C.				
M.				
M.				Pool <u>Wildcat</u>
K.				
Mz.				
Me.				
V.				
S.				
S.				
A.				
R.				
Pe.				
G.				
T.D.				

FIRST REPORT  
 APR 25 '56

Date Comm. 4-24-56  
8" @ 307 drlg. 2245

APR 25 1956

25

Co. Lse. No. Sec. T. R.