

Edwards.


DX 78-1

KANSAS

Section 33 Township 26 Range 18W

Well No. #1 Burton

Company Gulf Oil

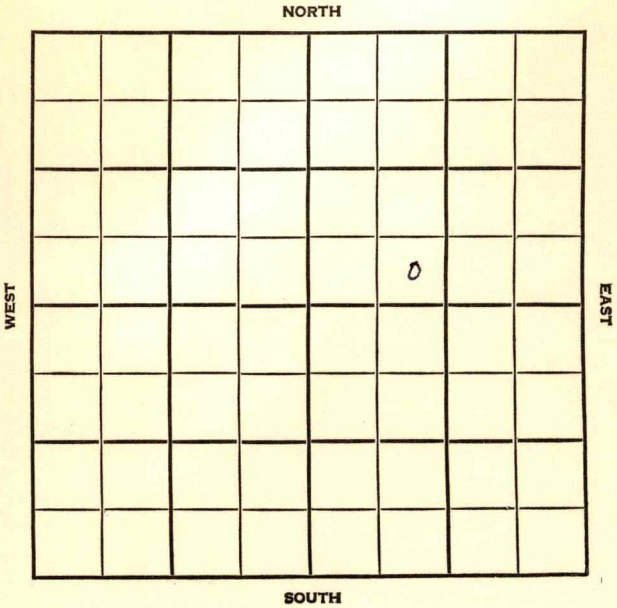

SEC.	TWP.	R.
33	26	18W

WELL NO. 1 Burton FARM

COMPANY Gulf Oil

CONTRACTOR Herndon Drlg.


Sturgeon Pool

_____ Ft. from N. Line

330 _____ Ft. from S. Line

1650 _____ Ft. from E. Line

_____ Ft. from W. Line

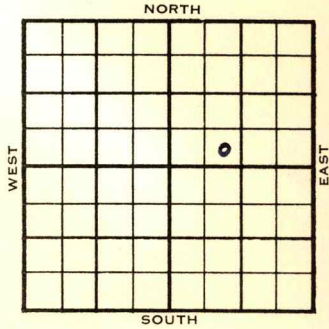

SE SW NE

	ELEVATION	REPORT
1954	2188'	

12/1
1955
2/9

Location
 spud 12-5-54 - Oil Well
 TD 4888'
 8-5/8" @ 669'
 Heeb. 3924', Doug. 3977', Br lime
 4067', Lans. 4073'
 DST 4220-43', opn 1 hr., gas in 1 hr.,
 rec. 220' VHO & GCM, 1355#
 Cong. ~~KX~~ 4626'
 DST 4620-57', op 1 hr., rec. 45' mud,
 735#
 Viola 4697'
 DST 4698-4730', opn 1 hr., rec. 270'
 gas, 40' mud, 390#
 Simp. 4752', Arb. 4849'
 DST 4850-55', opn 1 hr., rec. 25' mud,
 1545#
 DST 4855-88, opn 1 hr., rec. 120' msw,
 1560#
 TD 4888'
 5" @ 4861'
 CO to 4825'

OVER

(Information Brought Forward)

1955

2/9

48/4230-42, S/1.79 bo 4 hrs., 1000A

S/7 bo 88 bw 8 hrs.

PB 4239'

S/65 bw 1 hr., S/13 bo 356 bw 8 hrs.

CO 4239'

B/53 go 38 gw 4 hrs.,

CO to 4239

24/4225-33, 4 go 3 hrs., 500A

S/12 boph 2% wph

omp. 91 bopd 2 bw

COMPLETED

DAEB

Drig. Data

CO 4239 B/ 53 go 38 gw 4 hr. CO to

4239 24/ 4225-33 4 go 3 hr. 500 A

S/ 12 boph 2% wph

Comp. 91 bopd 2 bw

Misc.
 Pierce Map
 France Map
 Tracings
 Land Wall Map
 Land Survey Map
 Survey Guides

(Handwritten initials and a circled 'G' are present over the stamp.)

FEB 15 1955