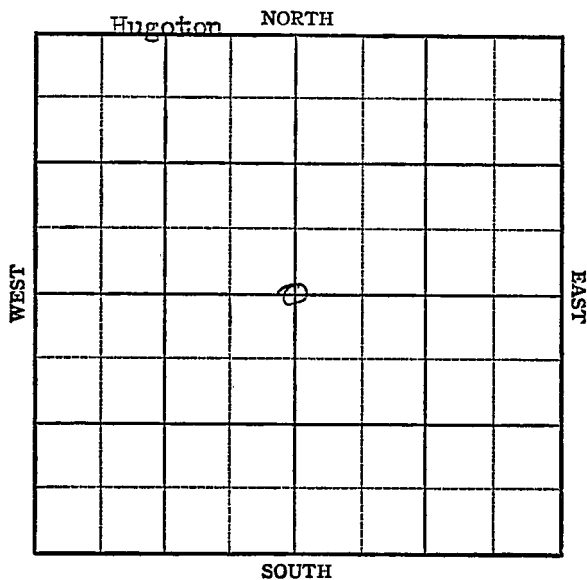


KANSAS^{Kearny}Section 18 Township 26 Range 36WWell No. 3 HillyardCompany Helmerich & Payne

KANSAS

Kearny

Sec. 18 Twp. 26 R. 36W

Well No. #3 Hillyard Farm


Helmerich & Payne Company
Hugoton

2640 Ft. from N. Line

 Ft. from S. Line

2640 Ft. from E. Line

 Ft. from W. Line

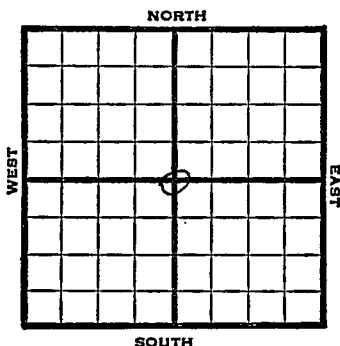

C SEC.

1947

REPORT

8/27 Location

9/3 RUR

9/10 Drlg. 1800'

9/17 10" @ 792'

TD 2442'

7" @ 2425'

9/24 TD 2625'

10/1 "

10/8 "

10/15 7" @ 2425
255' of 5" Perf liner
@ 2625
15,000 Acid
7,234,000 Gas
TD 2625

COMPLETED

Map No. _____ Sec. 18 Twp. 26 R. 36W

Well No. 3 Hillvard


Helmerich & Payne Company

FIRST REPORT

Contractor

C Sec. 2640

SECTION PLAT

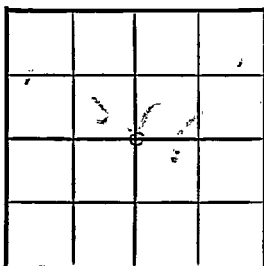

2640 Ft. from N. Line

Ft. from S. Line

2640 Ft. from E. Line

Ft. from W. Line

Kearny County

Location _____

Rig up _____

Drilling and Remarks:

RECORD

Cased _____ in., _____ ft.

Sand _____

Gas _____

Oil _____

Total Depth _____

PRODUCTION

1st 24 hrs. Nat. _____

1st 24 hrs. after shot _____

Gas _____ Cu. Ft.

Dry Hole _____

Abandoned _____

Date

AUG 27 1947 19

S. J. LEWIS

Scout

Map No. 0 Sec. 18 Twp. 26 R. 36W


Well No. 3 Hillyward

Helmerich & Payne Company

COMPLETE Contractor

C Sec.

SECTION PLAT

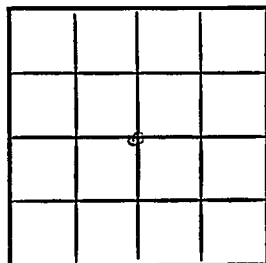

2640 Ft. from N. Line

 Ft. from S. Line

2640 Ft. from E. Line

 Ft. from W. Line

Kearny County

Location

Rig up

Drilling and Remarks:

7" @ 2425-

255' of 5" pipe line
@ 2625

1500000 oil

7,234,000 Gas

RECORD

Cased in., ft.

Sand

Gas

Oil

Total Depth 2625-

PRODUCTION

1st 24 hrs. Nat.

1st 24 hrs. after shot

Gas Cu. Ft.

Dry Hole

Abandoned

Date

OCT 15 1947 19

S I LEWIS

Scout