

KANSAS

Kearny

Section 18 Township 26 Range 35WWell No. 6-TateCompany Fin-Ker

Hugoton

NORTH

			0				

WEST

EAST

SOUTH

KANSAS

Kearny

Sec. 18 Twp. 26 R. 35W

Well No. 6 Tate Farm

Fin-Ker

Company


Mid West Contr. Hugoton Pool

 Ft. from N. Line

225 Ft. from S. Line

400 Ft. from E. Line

 Ft. from W. Line

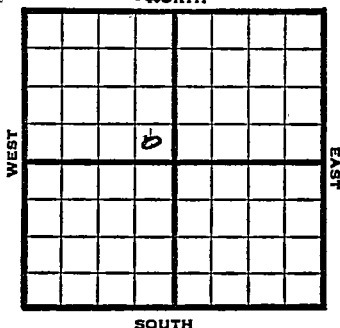

SE NW

1949

REPORT

7/27 10" @ 821

7" @ 2441

TD 2570'

8/3 "

8/10 "

8/17 "

8/24 "

8/31 "

9/7 "

9/14 "

9/21 TD 2655'

9/28 "

10/5 "

10/12 "

10/19 "

10/26 "

11/1 "

11/9 "

11/16 "

11/23 "

11/29 "

12/7 "

12/14 "

12/21 "

12/28 "

OVER

1950

1/11

TD 2655'

10" @ 821'

7" @ 2441'

Comp 1,746,000

gas per day

Comp

COMPLETED

Map No. 1 ~~Kansas~~ Sec. 18 Twp. 26 R. 35W

Well No. 6 Tate

Fin-~~Kar~~ Company

Mid West Contractor

FIRST REPORT

SE NW


SECTION PLAT

 Ft. from N. Line

225 Ft. from S. Line

400 Ft. from E. Line

1 Ft. from W. Line

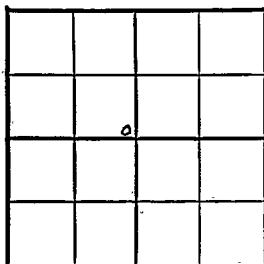

Kearny County

Location

Rig up

Drilling and Remarks:

10" @ 821

7" @ 2441

T D 2570

RECORD

Cased in., ft.

Sand

Gas

Oil

Total Depth

PRODUCTION

1st 24 hrs. Nat.

1st 24 hrs. after shot

Gas Cu. Ft.

Dry Hole

Abandoned

Date

JUL 27 1949 19

S. J. LEWIS Scout

Scout Cards
Land Small Map
Land Wall Map
Tracings
France Map
Pierce Map
Misc.


Map No. _____ Sec. 18 Twp. 26 R. 35WWell No. 6 Tate

_____ Fin-Ker _____ Company

_____ Contractor

SE NW

SECTION PLAT

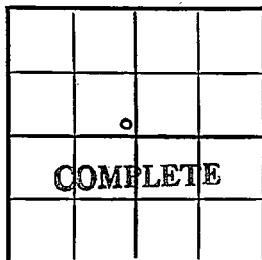

_____ Ft. from N. Line

_____ 225 Ft. from S. Line_____ 400 Ft. from E. Line

_____ Ft. from W. Line

-Kearny County

Location _____

Rig up _____

Drilling and Remarks:

10" @ 8217" @ 2441CampDeliver1.746,000Gas per Day.

RECORD

Cased _____ in., _____ ft.

Sand _____

Gas _____

Oil _____

Total Depth 2655

PRODUCTION

1st 24 hrs. Nat. _____

1st 24 hrs. after shot _____

Gas _____ Cu. Ft.

Dry Hole _____

Abandoned _____

Date

JAN 11 1950 19J. E. TYRA Scout

JAN 16 1950

Scout Cards	<i>Edith</i>
Land Small Map	
Land Wall Map	<i>3</i>
Tracings	
France Map	
Pierce Map	
Misc.	