

LAUGHLIN-SIMMONS & CO. OF KANSAS, INC.

Oil Well Elevations and Locations
2121 W. 18th 316-WH3-5351
Wichita, Kansas 67203

10-17-68

DATE

Edwards COUNTY 15 S 26s T 19w R

C SW SE LOCATION

Glen N. Rupe OPERATOR


1 NO. Craft FARM

Mr. Glen N. Rupe
222 Brown Building
Wichita, Kansas 67202

Authorized by Faye Leach Scale

2223 DF Tel. No. Elevation

Left at Rig.

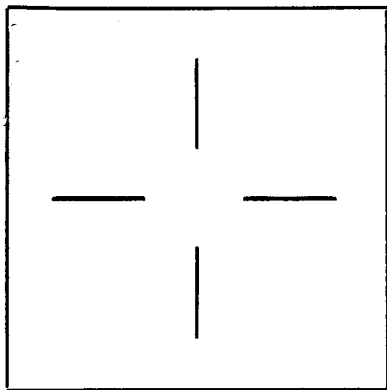

Remarks:

Thanks

Dr. Lammahill LS Engineer

Minimum Staking Charge: \$20.00 ✓
Elevation Charge:
Extra Time and Mileage:
TOTAL \$20.00