

State of Kansas



State Corporation Commission

CONSERVATION DIVISION

(Oil, Gas and Water)

500 Insurance Bldg.

212 N. Market

WICHITA, KANSAS 67202

December 19, 1969

DEC 20 1969

WELL PLUGGING AUTHORITY

Well No.	1
Lease	Titus
Description	C SW SW 4-26-19W
County	Edwards
Total Depth	4900
Plugging Contractor	Russ Casing Pulling Co.


G. N. Rupe  
222 Brown Bldg.,  
Wichita, Kansas 67202

Gentlemen:

This is your authority to plug the above subject well in accordance with the Rules and Regulations of the State Corporation Commission.

This authority is void after 90 days from the above date.

Very truly yours,

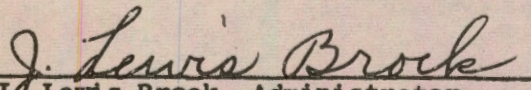
  
J. Lewis Brock, Administrator

Mr. Herman Justus Box 71 Nickerson, Kansas  
is hereby assigned to supervise the plugging of the above  
named well.

WELL PLUGGING RECORD

Give All Information Completely  
Make Required Affidavit  
Mail or Deliver Report to:  
Conservation Division  
State Corporation Commission  
212 No. Market  
Wichita, Kansas

NORTH

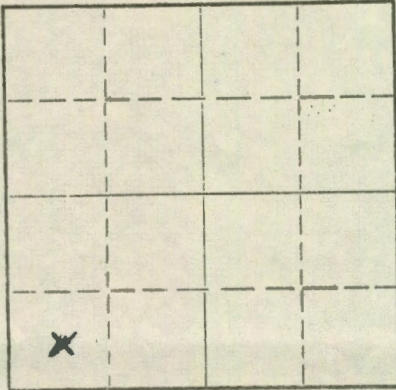

Locate well correctly on above Section Plat

Location as "NE/CNW\*SW\*" or footage from lines Edwards County, Sec. 4 Twp. 26 Rge. 19 (E) W (W)  
 Lease Owner Glen Rupe  
 Lease Name Titus Well No. #1  
 Office Address 222 Brown Bldg. Wichita, Kansas  
 Character of Well (completed as Oil, Gas or Dry Hole) \_\_\_\_\_  
 Date well completed \_\_\_\_\_ 19\_\_\_\_  
 Application for plugging filed December 1969  
 Application for plugging approved December n 1969  
 Plugging commenced December 19 1969  
 Plugging completed December 24 1969  
 Reason for abandonment of well or producing formation \_\_\_\_\_

If a producing well is abandoned, date of last production \_\_\_\_\_ 19\_\_\_\_  
 Was permission obtained from the Conservation Division or its agents before plugging was commenced? Yes

Name of Conservation Agent who supervised plugging of this well Herman Justice  
 Producing formation \_\_\_\_\_ Depth to top \_\_\_\_\_ Bottom \_\_\_\_\_ Total Depth of Well \_\_\_\_\_ Feet  
 Show depth and thickness of all water, oil and gas formations.

OIL, GAS OR WATER RECORDS

CASING RECORD

FORMATION	CONTENT	FROM	TO	SIZE	PUT IN	PULLED OUT
				8 5/8	283	None
				4 1/2	4900	2528

Describe in detail the manner in which the well was plugged, indicating where the mud fluid was placed and the method or methods used in introducing it into the hole. If cement or other plugs were used, state the character of same and depth placed, from \_\_\_\_\_ feet to \_\_\_\_\_ feet for each plug set.

December 19, 1969 Dumped sand to 4650'. Mixed and dumped 4 sx of cement to 4600'.  
December 24, 1969 Allied Cementing Co. mixed and pumped down 8 5/8" casing, 15 sx of gel and 75 sx of cement + 6% gel. Job finished at 10:30 A.M. Max. pressure 350 lbs.

(If additional description is necessary, use BACK of this sheet)

Name of Plugging Contractor RUSS CASING PULLING, INC.  
 Address P. O. Box 1082 Great Bend, Kansas 67530

STATE OF Kansas, COUNTY OF Sedgwick, ss.  
Glen N. Rupe (employee of owner) or (owner or operator) of the above-described well, being first duly sworn on oath, says: That I have knowledge of the facts, statements, and matters herein contained and the log of the above-described well as filed and that the same are true and correct. So help me God.

(Signature) \_\_\_\_\_

222 Brown Building, Wichita, Kansas  
(Address) 67202

SUBSCRIBED AND SWORN TO before me this 31st day of December, 1969

My commission expires September 16, 1973

Faye W. Leach

Notary Public.