

State of Kansas



JOHN CARLIN  
R. C. LOUX  
JANE T. ROY  
PHILLIP R. DICK  
CAROL J. LARSON

Governor  
Chairman  
Commissioner  
Commissioner  
Executive Secretary

State Corporation Commission

CONSERVATION DIVISION

(Oil, Gas and Water)  
200 Colorado Derby Building  
202 West 1st Street  
WICHITA, KANSAS 67202

June 30, 1981

JUL 2 1981

WELL PLUGGING AUTHORITY

Well No.	1
Lease	Titus
Description	SW SE SW
Section	11-26S-19W
County	Edwards
Total Depth	4754'
Plugging Contractor	Kelso Casing Pulling

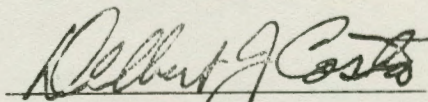
Rupe Oil Company, Inc.  
P.O. Box 2273

434 Ohio  
Wichita, KS. 67201  
Gentlemen:

This is your authority to plug the above subject well in accordance with the Rules and Regulations of the State Corporation Commission.

This authority is void after ninety (90) days from the above date.

Yours very truly,

  
Administrator

Mr. Maurice Leslie, R. R. #1, Nashville, KS, 67112

is hereby assigned to supervise the plugging of the above named well.

STATE OF KANSAS  
 STATE CORPORATION COMMISSION  
 200 Colorado Derby Bldg.  
 Wichita, Kansas 67202

Form CP-4  
 Rev. 12-15-80

WELL PLUGGING RECORD

Give All Information Completely  
 Make Required Affidavit

COUNTY Edwards SEC. 11 TWP. 26S RGE. 19W E/W  
 Location as in quarters or footage from lines:

SW SE SW

	11		

Lease Owner Rupe Oil Company, Inc.  
 Lease Name Titus Well No. #1  
 Office Address P.O. Box 2273 434 Ohio Wichita, Kansas 67201  
 Character of Well (Completed as Oil, Gas or Dry Hole): \_\_\_\_\_  
 Date Well Completed \_\_\_\_\_  
 Application for plugging filed \_\_\_\_\_  
 Plugging commenced 9-24-81  
 Plugging completed 9-29-81  
 Reason for abandonment of well or producing formation \_\_\_\_\_

Locate Well  
 correctly on above  
 Section Platt.

Depleted

Was permission obtained from the Conservation Division or it's  
 Agent's before plugging was commenced? yes

Name of Conservation Agent who supervised plugging of this well Paul Luthi

Producing formation \_\_\_\_\_ Depth to top \_\_\_\_\_ bottom \_\_\_\_\_ T.D. 4754'

Show depth and thickness of all water, oil and gas formations.

OIL, GAS OR WATER RECORDS

Casing Record

Formation	Content	From	To	Size	Put in	Pulled Out
				8-5/8"	268'	none
				4-1/2"	4748'	2530'

Describe in detail the manner in which the well was plugged, indicating where the mud  
 fluid was placed and the method or methods used in introducing it into the hold. If cement  
 or other plugs were used, state the character of same and depth placed, from \_\_\_\_\_ feet  
 to \_\_\_\_\_ feet for each plug set.

Moved in on location, made bottom plug back with sand to 4700' and set 4 sacks cement.  
 Pulled 19" tension, shot pipe @2520' and pulled 69 joints of casing. Plugged well  
 with 4 sacks hulle, 25 sacks gel, 8-5/8" plug, 125 sacks 50/50 pos, 4% gel, 3% cc.  
 Plugging completed.

(If additional description is necessary, use BACK of this sheet)

Name of Plugging Contractor Kelso Casing Pulling

STATE OF Kansas COUNTY OF Rice, ss.  
R. Darrell Kelso (employee of owner) or (owner or operator) of the  
 above-described well, being first duly sworn on oath, says: That I have knowledge of the  
 facts, statements, and matters herein contained and the log of the above-described well as  
 filed and that the same are true and correct. So help me God.

(Signature) [Signature]  
Chase, Kansas  
 (Address)

SUBSCRIBED AND SWORN TO before me this 12th day of October, 19 81

My Commission expires:



[Signature]  
 Notary Public.