

KANSAS


FORM 51 IOM 12-46 PETROL

Finney

Section 19 Township 26 Range 34W

Well No. 1 Delbin

Company Howard Kuhn

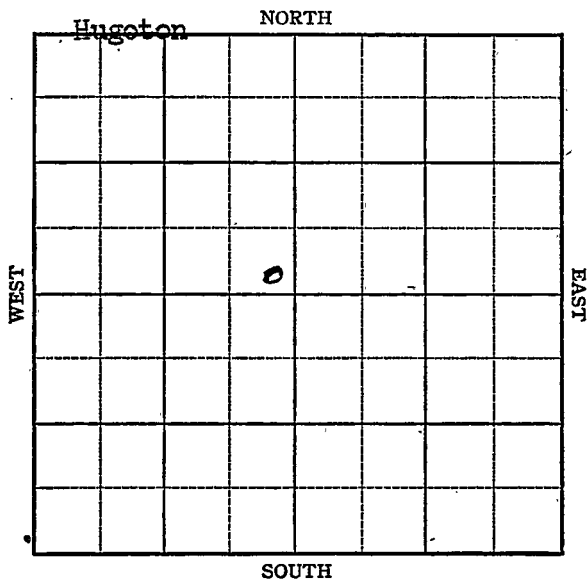

Sec. 19 Twp. 26 R. 34W

Well No. 1 Delbin Farm

Howard Kuhn Company

Finney County


Ft. from N. Line

100 Ft. from S. Line

100 Ft. from E. Line

Ft. from W. Line

SE NW

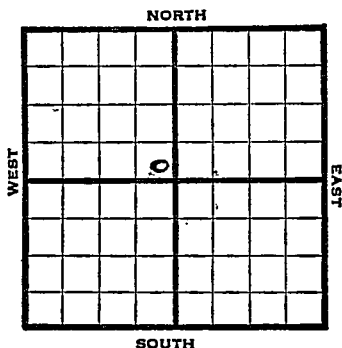

1947 Elev. 2981' REPORT

3/26	Location
4/2	RUR
4/9	"
4/15	"
4/23	"
4/29	10" @ 600' WOC
5/7	Drlg. 2400'
5/13	TD 2495' 7" @ 2485' RUST
5/20	" "
5/27	" "
6/3	" "
6/10	" "
6/17	TD 2495'
6/24	Drlg. 2590'
7/1	"

OVER

1947

7/8 TD 2600'

7/16 "

7/23 7" @ 2485'
190' of 5" Perf lines. @ 2660'
30,000 acid.
23,749,000 Gas
R. Pr. 423#
T.D. 2660'
Complete

COMPLETED

Map No. _____ Sec. 19 Twp. 26 R. 34W

Well No. 1 Delbin

Howard Kuhn Company

FIRST REPORT

Contractor

SE NW

SECTION PLAT

 Ft. from N. Line

100 Ft. from S. Line

100 Ft. from E. Line

 Ft. from W. Line

Finney County

Location X

Rig up _____

Drilling and Remarks:

RECORD

Cased _____ in., _____ ft.

Sand _____

Gas _____

Oil _____

Total Depth _____

PRODUCTION

1st 24 hrs. Nat. _____

1st 24 hrs. after shot _____

Gas _____ Cu. Ft.

Dry Hole _____

Abandoned _____

Date

MAR 26 1947

19

S. J. LEWIS

Scout

no need


Misc Small Maps	<i>E</i>
Cards	<i>Roll</i>
Tracing	
France Map	<i>A</i>
Scarborough Map	<i>A</i>
Pierce Map	
Geological Dept.	
Pierce Plat Book	

KansasMap No. 0 Sec. 19 Twp. 26 R. 34WWell No. 1 DelbinHoward Kuhn

Company

COMPLETE

Contractor

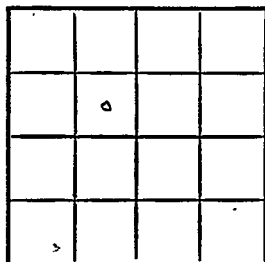C SE NWE12987
SECTION PLATFt. from N. Line660 Ft. from S. Line660 Ft. from E. LineFt. from W. LineFinney County

Location

Rig up

Drilling and Remarks:

7" C2485170' x 5" Pay linesC266030000 acid23,749,000 Gas423* R Fe

RECORD

Cased _____ in. _____ ft.

Sand _____

Gas _____

Oil _____

Total Depth 2660

PRODUCTION

1st 24 hrs. Nat. _____

1st 24 hrs. after shot _____

Gas _____ Cu. Ft.

Dry Hole _____

Abandoned _____

Date

JUL 23 1947S. J. LEWIS19

Scout

Misc. Small

Cards

Tracing

France Map

Scarborough Map

Pierce Map

Geological Dept.

Pierce Plat Book