


Finney

KANSAS

SECTION 19 TOWNSHIP 26S RANGE 34W

WELL NO. #1 Kuhn-Devlin

COMPANY McKnab & Lindsay

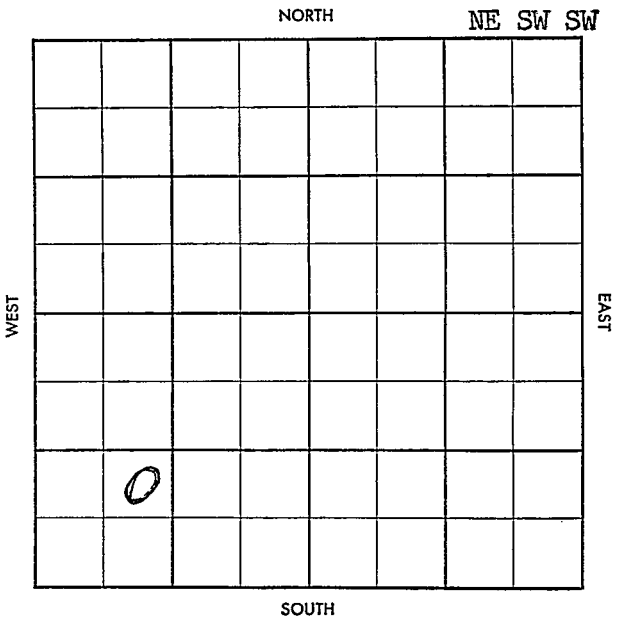

35

County Finney Elev. _____
 Sec. 19 Twp. 26 Rge. 34W
 Company McKnab & Lindsay
 Farm Name Kuhn-Devlin No. 1

TOPS	DEPTH	LOG	DATUM	Loc. in Sec.
Anh.				NE SW SW
Tp.				
H.				
Tr.				
Dg.				
Bl.				
L.				Geol. _____
K.C.				Contr. _____
B.K.C.				Co. tools
Ce.				
C.				
M.				Pool _____
M.				N. Pleasant
K.				Prairie
Mz.				
Mo.				
V.				
S.				
S.				
A.				
R.				
Pe.				
G.				
T.D.				

	SEP 18 31
11:21	RECORDED

Date Comm. 9-16-57

drlg.

Co.

Lse.

No.

Sec.

T.

R.

CORRECTION

FORM 513 SUNRAY

County Finney Elev. 3001
 Sec. 19 Twp. 26 Rge. 31W
 Company McKnab & Lindsay
 Farm Name Kuhn-Devlin No. 1-19

TOPS	DEPTH	LOG	DATUM	Loc. in Sec.
Ank				NE SW SW
Tr.	3436	3436		
H.	3859	3856		
Tr.		3874		
Dg.				
BL				
L.	3904	3903	-903	Geol.
M.C. also	4828			Contr.
BKCM also	4903			Co. tools
Ce. also	4989-98			
C. also	4998			
M. also	5042			
M. also		4456		Pool
K. also		4074		N. Pleasant
M. also		4606		Prairie
Mo. also		4838		
V. also		4902		
S. also		4997		
S. also		5061		
A.				
R.				
PE.				
G.				
ED.	5172			

COMPLETE
 DEC 1 1957

Date Comm. 9-16-57

drilg. SEP 25 57 8" ~~8 1/2~~ 43 1/2 / 450
 W.C. OCT 2 57 ID 26 / D OCT 9 57 D 4200
 OCT 16 57 D 57 ~~4258~~ - 86 60"
 225' MSW FP 80-80 BHP 1160 / 30
 end 4970-5020 full sec
 end 5022-67 OCT 23 57 45' ms
 end 5067-5105 38' 3' lin. ms.
 1 1/2 lin Buff sparsely 30' lin
 dense 5' line trail

Lrd 5105-40 re 35' 4' line
 dense fin cups N.S 3' line
 trace oil 8' line good porosity
 30' 3' line 17' line dense
 trace oil ~~line~~ 5 1/2 5164/375
 ran log OCT 30 57 CD 5130 44/5107
 - 5118 1/2 on Ld. NOV 6 57
 \$ 14 BOPD MW run
 \$ 360 BOPD MW run 24 hrs
 P 118 BOPD NW 9 hrs
 allow 48 BOPD

Miss 5107-18
 TD 5172

19-26-34W

measured