


Finney

KANSAS

SECTION 19 TOWNSHIP 26S RANGE 34W

WELL NO. #2-19 Kuhn-Devlin

COMPANY McKnab & Lindsay

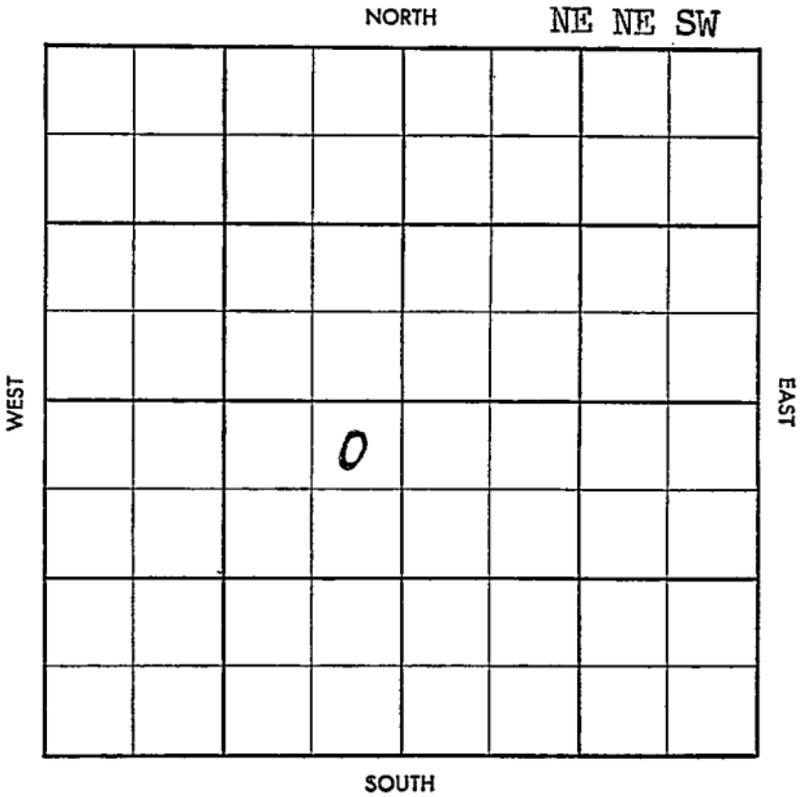

272

County Finney Elev. _____
 Sec. 19 Twp. 26 Rge. 34W
 Company McKnab & Lindsay
 Farm Name Kuhn-Devlin No. 2-19

TOPS	DEPTH	LOG	DATUM
Anh.			
Tp.			
H.			
Tr.			
Dg.			
B.L.			
L.			
K.C.			
B.K.C.			
Ce.			
C.			
M.			
M.			
K.			
Mz.			
Mq.			
V.			
S.			
S.			
A.			
R.			
Pf.			
G.			
T.D.			

Loc. in Sec. _____
NE NE SW
 Geol. _____
 Contr. _____
 Co. Tools _____
 Pool Pleasant
 Prairie No. _____

FEB 19 58
FIRST REPORT

Date Comm. _____
MIRT

Co.
Lse.
No.
Sec.
T.
R.

~~Top~~ ~~Foot~~
~~Dr.~~ ~~Foot~~

5-513-B

County Finney Elev. 2987.01 = 2712.4
 Sec. 19 Twp. 26 Rge. 34W
 Company McKnab & Lindsay
 Farm Name Kuhn-Devlin No. 2-19

TOPS	DEPTH	LOG	DATUM
Anh.			
Tp.	3440		
H.	3967	3870	
Tr.		3886	
Dg.			
B.L.			
L. on	3917	3922	
K.C.			
B.K.C. max	4489	4491	
Ce.	4637	4645	
C. At 0.2	4852	4861	
M. max	4921	4923	
M. 5762	5009	5011	
K. 5762		5065	
Mz.			
Mq.			
V.			
S.			
S.			
A.			
R.			
Pf.			
G.			
T.D.	5174		

Loc. in Sec. _____
 NE NE SW
 Geol. _____
 Contr. _____
 Co. Tools _____
 Pool Pleasant
 Prairie No. _____

COMPLETE
 0
 APR 16 '58

Date Comm. 2-25-58
 MIRT MAR 5 '58 8" 803 03010
MAR 12 '58 4430 MAR 14 '58 end 4997-0
5013 - 25' NS end 5013-63
50' NS end 5063-98 MAR 22 '58
35' NS end 5098-5135
37' Log 5 1/2" 5174/
W O C T 204 - .3 .4 - 58 Co 5150 48/5120
-32 prep to 8" APR 16 '58 680ph NWNT
42 Boph NWNT P 130 B and NW
P 42 Boph NW

Co.
 Sec.
 No.
 Sec.
 T.
 R.