

Finney

KANSAS


SECTION 19 TOWNSHIP 26S RANGE 34W

WELL NO. #4 Kuhn-Devlin

COMPANY McKnab & Lindsey

NORTH

NE SW NW

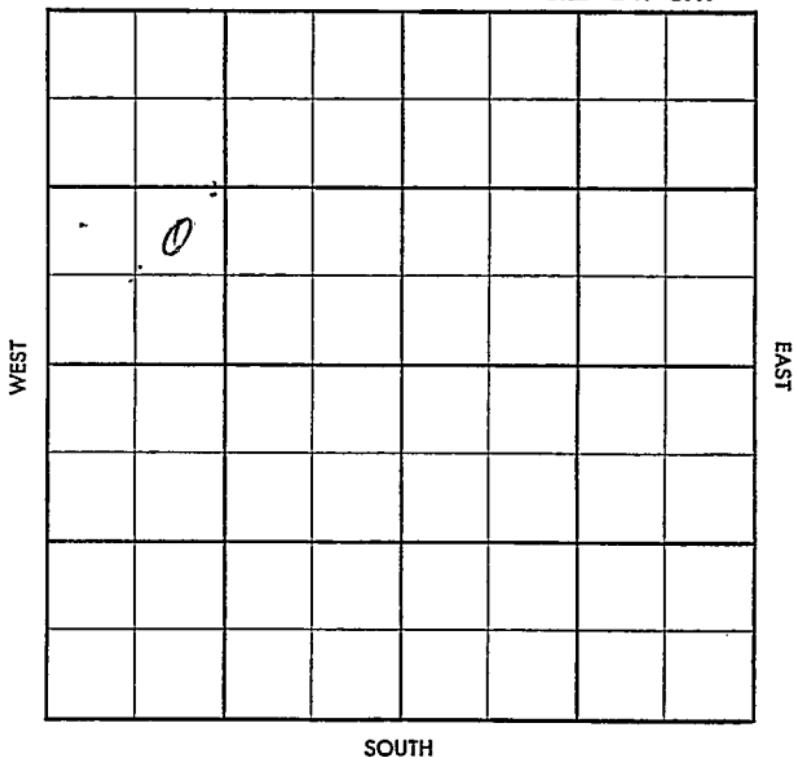

~~Wittgenstein~~ Paul

Block 382

S-513.B

County Finney Elev. ..

Sec. 19 Twp. 26 Rge. 34W

Company McKnab & Lindsey

Farm Name Kuhn-Devlin No. 4

TOPS	DEPTH	LOG	DATUM	Loc. in Sec.
Anh.				NE SW NW
Tp.				
H.				
Tr.				
Dg.				
B. L.				
L.				
K.C.				Geol.
B.K.C.				
Ce.				Contr.
C.				Co. tools
M.				
M.				Pool
K.				
Mz.				N. Pleasant
Mq.				Prairie
V.				
S.				
S.				
A.				
R.				
Pf.				
G.				
T.D.				

Date Comm.-

### Location

~~CORRECTION~~

~~Pool~~

~~Co.~~

~~Facet~~

S-513-B

County Finney Elev. 2978 ft. 2975 ft.  
 Sec. 19 Twp. 26 Rge. 34W  
 Company McKnab & Lindsey  
 Farm Name Kuhn-Devlin No. 4-19

TOPS	DEPTH	LOG	DATUM	Loc. in Sec.
Anh.	3425			NE SW NW
Tp.				
H.	3852			
Tr.				
Dg.				
B.L.				
L.	3900			
K.C. mark	4670			
B.K.C. 4305	4839			
Ce. MARSH	4902			
C.S. 600	4983	4287		
M. ST LOUIS	5078	5077		
M.				
K.				
Mz.				
Ma.				
V.				
S.				
S.				
A.				
R.				
Pf.				
G.				
T.D.	5192			JUN 25 '58

Date Comm. 5-19-58 8" 805  
 Location 34° 21' E 97° 28' S 3500 ft

AM 3:58 Ø 4030 JUN 11 58 DST 4405-35

op 1 hr 520' SW 540 1200/20" cal

4975-96 sec 6' 2' sh ssdy

1' Li ssdy 1' so + gas 2' Li dense

sec 1' Li shly stony end 4986-5015

sec 29' 3' Li shly so, 7' Li dense bldgo

6' Li ssdy 9' Li cal ssdy ns 2' Li

pence ns 2' Li cal ssdy end 5015

64 sec 49' 2' ss cal Bldgo. or it

FORM 513-1 SUNRAY

38' Li. white dense sdy NS  
8' gravel and 5065-5103 JUN 18 '68  
full rec 13' 5" , 3' Li dense Foss  
NS 5' Li Foss. o'i'stein 4' Li  
dense vs cherty 1' Li ool. 11' Li  
3' por & o'i'stein 1' Li ns and 5129-54  
2 4 1/2' rec. 8 1/2' Li dense XLn ool  
cherty 13' Li ool. & troj'. ool  
~~5' log~~ 5" 5191/ JUN 23 '68

CD 5170 40/5137-47 \$130ph  
NW 1/4, F.vac 10 x 10 \$ 45-50  
BD ph NW por P.200 Bopd NW  
P. 37 Bopd NW

f

19-26-34W

ne sun mtn