

SECTION 19 TOWNSHIP 26S RANGE 34W

WELL NO. #6-19 Kuhn-Devlin


COMPANY McKnab & Lindsey

NORTH

C NE SE

WEST

EAST

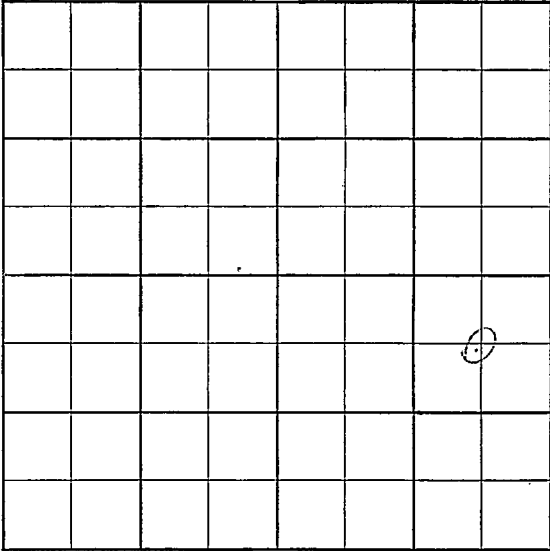

SOUTH

Twp Pool
 Co. CORRECTION
 CORRECTION

S-513-B

County Finney Elev 2990 KB 2987 D
 Sec. 19 Twp. 26 Rge. 34
 Company McKnab & Lindsey
 Farm Name Kuhn-Devlin No. 6-19

TOPS	DEPTH	LOG	DATUM
Anh.			
Tp.	3456		
H.	3879	3875	
Tr	3895	3889	
Dg.			
B.L.			
L.	3928	3934	
K.C. <u>marl</u>	4491	4487	
B.K.C. <u>stoc</u>	4849	4843	
Ce. <u>mor</u>	4909	4905	
<u>stoc</u>	4994	4990	
M. <u>St Louis</u>	5037	5033	
M. <u>zone</u>	5046	48	
K.			
Mz.			
Mq.			
V.			
S.			
S.			
A.			
R.			
Pf.			
G.			
T.D.	5175		

Loc. in Sec. SE
8 T. 31
N/2
250 FNL
550 FEL

Geol.
 Contr.
 Co. Tools
 Pool
 Pleasant
 Prairie No

COMPLETE
 AUG 27 '58

Date Comm. 7-17-58 8" 814
 LERT JUL 23 '58 ϕ 2810 JUL 30 '58 ϕ 4300
AUG 6 '58 Core 4978-99 rec 21' 4'sd
shly 12' sh 5' Li sdy so
 Core 4999-5020 rec 21' 11' Li
10' Li sdy ns Core 5041-87 rec 46'
Li, oolitic, sdy, so. remaining AUG 13 '58
 core 5088-5118 rec 29 1/2' 1 1/2
sh 26' dense Li 2' ool Li so
 core 5118-38 rec 20' 1 1/2' ool Li so
9' dense Li Log Pipaset AUG 20 '58

Co. Sec. No. Sec. T. R.

5° 5174 52/3111-24 \$10 Boph
NW A \$35 Boph NW govt STA
Pop P. 185 Bopd NW
allow ~~5~~ Bopd

AUG 27 '58

allow 67 Bopd NW

19-26-36 W.