


Section 2 Township 26 Range 33W

Well No. 1 Russell "B"

Company Stanolind Oil and Gas Company

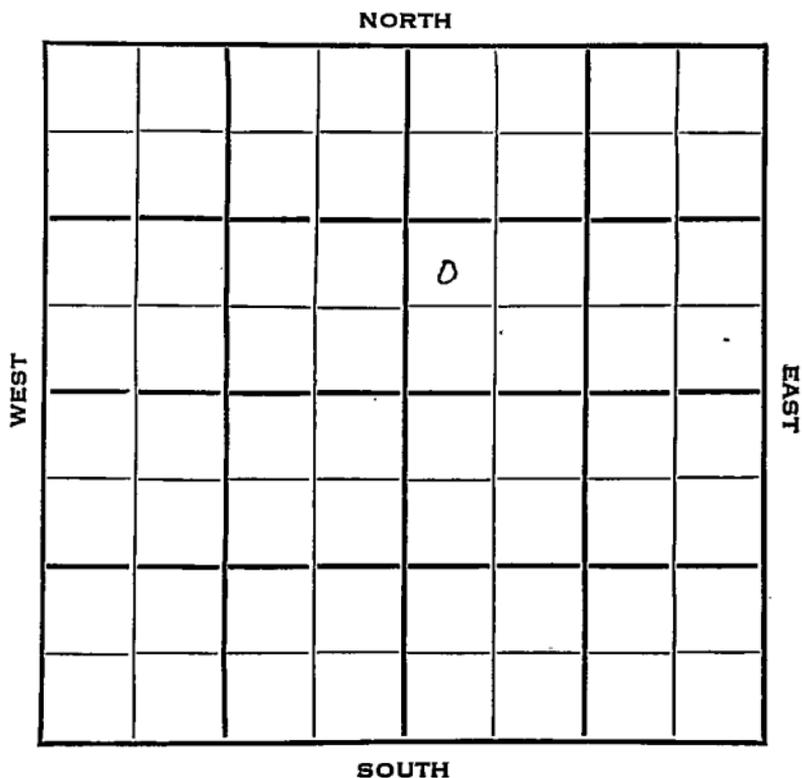

Sec. 2 Twp. 26 R. 33 W

Well No. # 1 Russell "B" Farm

Stanolind Company

Contractor


Ft. from N. Line

737 Ft. from S. Line

Ft. from E. Line

150 Ft. from W. Line

NW SW NE

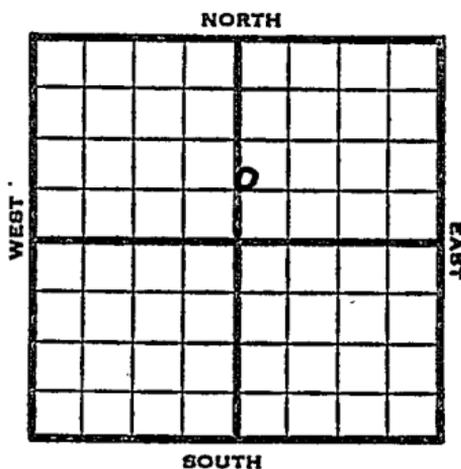

1953

Elev. 2909' REPORT

1/21

Location

1/29

"

2/5

8" @ 907

Her Kr 2586, Win 2644,

RTD 2665,

5" @ 2644

2/12

NR

2/19

DD 2670'

2/26

TD 2670 156/2586-2604 12/2614-16

18/2619-21 12/2625-27 16,000A

3/4

Spud 1-26-53

Gas Well

TD 2670

8" @ 907

Her 2586, Win 2644

TD 2665

5" @ 2644

DD 2670

156/2586-2604, 12/2614-16

18/2619-21, 12/2625-27, 16000A

Comp. 5,901,000 330#

COMPLETED

