

KANSAS

Kearny

FORM 51 10M 12-46 PETROL

Section 20 Township 26 Range 36-W

Well No. 4 Hillyard


Company Helmerich & Payne

Hugoton Pool

NORTH

WEST

EAST

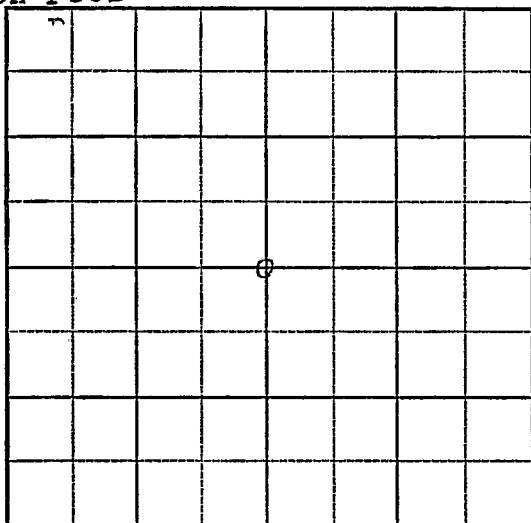

SOUTH

KANSAS

Kearny

Sec. 20 Twp. 26 R. 36W

Well No. #4 Hillyard Farm


Helmerich & Payne Company
Hugoton

2640 Ft. from N. Line

 Ft. from S. Line

2640 Ft. from E. Line

 Ft. from W. Line

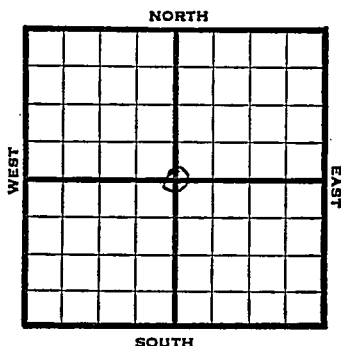

C Sec.

1947	Elev. -	REPORT
9/17	Location	
9/24	10" @ 800' Drlg. 2470'	
10/1	7" @ 2519' -2640 3000 Acid Drlg. 2650'	
10/8	TD 2720'	
10/15	252' of 5 Perf liner @ 2720'	
10/22	"	
10/29	"	
11/5	"	
11/12	"	
11/19	TD 2720' Set 252' of 5" Perf. Liner @ 2720'	
11/25	"	
12/3	7" @ 2519' 252' of 5" Perf liner @ 2720 Acid 15,000 Gas 1,593,000 Rock Pr. 424# Total Depth 2720'	
	COMPLETED	

Map No. 0 Sec. 20 Twp. 26 R. 36W

Well No. 4 Hillyard

Helmerich & Payne Company

FIRST REPORT

Contractor

C Sec.


SECTION PLAT

2640 Ft. from N. Line

 Ft. from S. Line

2640 Ft. from E. Line

 Ft. from W. Line

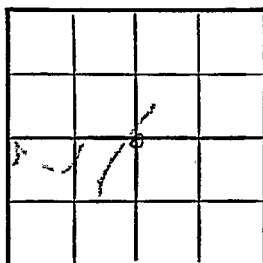

Kearny County

Location X

Rig up
Drilling and Remarks:

RECORD

Cased in., ft.

Sand

Gas

Oil

Total Depth

PRODUCTION

1st 24 hrs. Nat.

1st 24 hrs. after shot

Gas Cu. Ft.

Dry Hole

Abandoned

Date

SEP 17 1947 19 S. J. LEWIS Scout

Map No. _____ Sec. 20 Twp. 26 R. 36W

Well No. 4 Hillyard

Helmerich & Payne Company

COMPLETE Contractor

C Sec.


SECTION PLAT

2640 Ft. from N. Line

_____ Ft. from S. Line

2640 Ft. from E. Line

_____ Ft. from W. Line

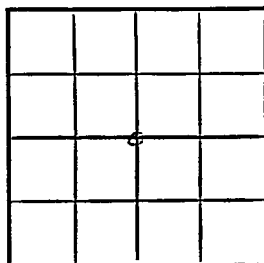

Kearny County

Location _____

Rig up _____

Drilling and Remarks:

7" C 2519
252' of 5" Perf. lines
C 2720
15000 sand
1,573,000 Gas.

*424 * R/R*

RECORD

Cased _____ in., _____ ft.

Sand _____

Gas _____

Oil _____

Total Depth 2720

PRODUCTION

1st 24 hrs. Nat. _____

1st 24 hrs. after shot _____

Gas _____ Cu. Ft.

Dry Hole _____

Abandoned _____

Date

DEC 3 1947

19

S. J. LEWIS

Scout