


Section 10 Township 26 Range 21 WWell No. # 1 BierwagenCompany Northern Natural Gas

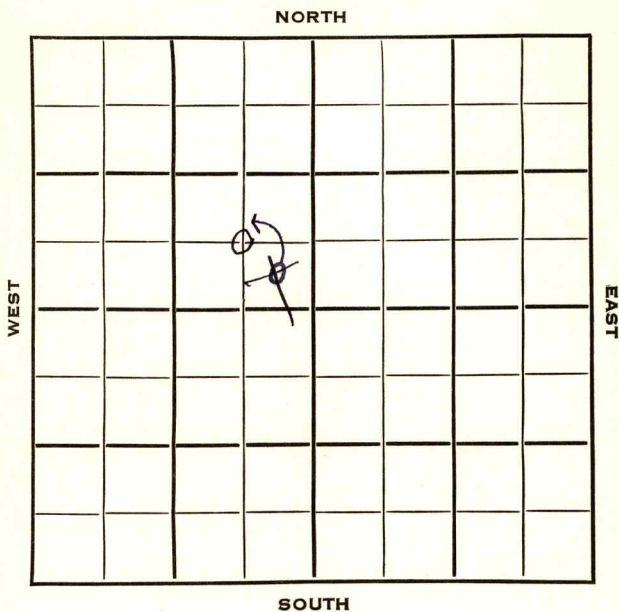

Sec. 10 Twp. 26 S R. 21 W

Well No. # 1 Wetzel Bierwagon Farm

Northern Natural Gas Prod. Co. Company

Moran Drlg. Contractor
Wildcat

Ft. from N. Line

660
330

Ft. from S. Line


660
330

Ft. from E. Line

Ft. from W. Line

C
SE SE NW

MCPC \$3500 DHM

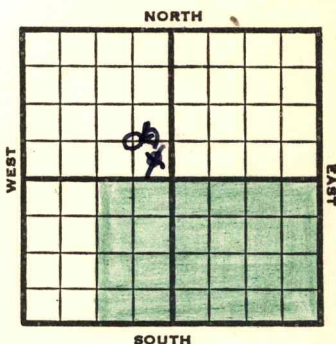

1953

Elev. 2289'

REPORT

Mississippi Lime Test approx 4900'

8/17

To commence not later than Sept. 5, 1953
To complete not later than Dec. 4, 1953

8/26

Location

(F.R. Ticket

9/3
9/9

"
"

(Ltr-McGehee)

9/17

Spud 9-14-53
Drlg. 240'

" "

9/24

Her. 2515'
Drlg. 2670'
Drlg. 3866'

" "
" "

10/1

10/8

Lans 4166'

DST 4448-77 open 1 hr good blow
rec 1860' SW, NS. IFP 50#
FFP 900# BHP 1550#

SO 4722-26 & 4730-40'

To take DST.

(Ltr-McGehee)

10/15

D & A

" "

10/14

Spud 9-14-53
D & A
TD 4915'
10" @ 695'

Her. 2515, Lans 4166,

DST 4448'-77' opn 1 hr, rec 1860' SW
IFP 50# FFP 900#, HFP 2400#

OVER


1953

Information brought forward.

10/14 BHP 1500#
DST 4716'-44' opn 1 hr, rec 8' sgcm
O# **Miss 4800'**
DST 4800'-18' opn 2 hr, rec 1215'
gcsw 1325#
TD 4915'
D & A

ABANDONED

County Ford State Kansas
Sec. 10 (Blk.) 26 (Sur.) 21W Map No.
(Twp.) (Rge.)
Operator Northern Natural Gas
Well No. 1 Farm Bierwagen
Elev. Location SE SE NW

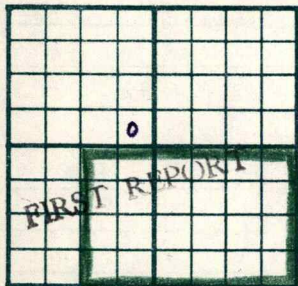

330 Ft. From S Line NW
330 Ft. From E Line Quarter
1st. Report AUG 26 1953
Completion
Remarks MCPC - support
Moran Drlg. - Contr.
Spudding Date

Drlg. Data Wildcat
Location

J. G. McGEHEE

County Ford State KansasSec. 10 (Blk.
Twp.) 26 (Sur.
Rge.) 21 W Map No.Operator Northern Natural GasWell No. 1 Farm BierwagenElev. 2289 Location C SE NW660 Ft. From S Line NW660 Ft. From E Line Quarter

1st. Report

Completion OCT 14 1953Remarks WildcatMoran Drlg. - Contr.Spudding Date 9-14-53Drlg. Data D & A TD 491510" @ 695 Her. 2515 Lans. 4166DST 4448-77 open 1 hr. Rec. 1860' swTFP 50# FFP 900# HFP 2400# BHP 1500#DST 4716-44 open 1 hr. Rec. 8' sgcm 0#Miss. 4800 DST 4800-18 open 2 hr.Rec. 1215' gcsw 1325# TD 4915D & A

J. G. McGEHEE

A 18838

Map No. _____ Sec. 10 Twp. 26 R. 21WWell No. 1 Bierwagen_____
Northern Natural _____ Company_____
CORRECTION _____ Contractor

C SE NW

SECTION PLAT

	0		

Ft. from N. Line660
Ft. from S. Line660
Ft. from E. Line_____
Ft. from W. Line

Ford County

Location _____

Rig up _____

Drilling and Remarks:

Reported

SE SE NW

RECORD

Cased _____ in., _____ ft.

Sand _____

Gas _____

Oil _____

Total Depth _____

PRODUCTION

1st 24 hrs. Nat. _____

1st 24 hrs. after shot _____

Gas _____ Cu. Ft.

Dry Hole _____

Abandoned _____

Date

SEP 30 1953

19

J. G. McGEHEE

Scout