


Section 21 Township 26 Range 39W

Well No. 1 Doerr "B"

Company Stanolind

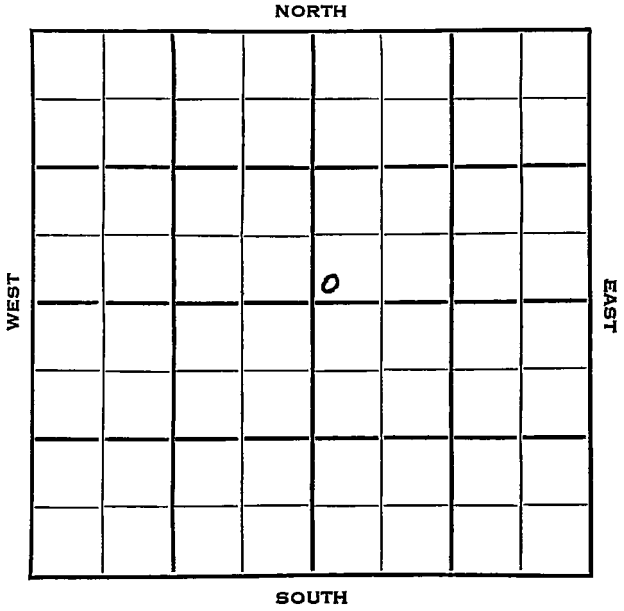

Hamilton KANSAS

SEC. 21	TWP. 26	R. 39 W ✓
------------	------------	--------------

WELL NO. # I Doerr "B" FARM

COMPANY Stanolind

CONTRACTOR

Hugoton Pool


_____ Ft. from N. Line

150 _____ Ft. from S. Line

_____ Ft. from E. Line

150 _____ Ft. from W. Line

SW SW NE

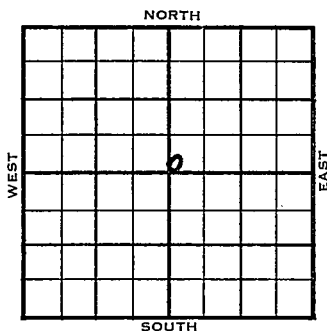

	ELEVATION	REPORT
1953	3340'	
11/4	Spud 11-1-53 8" @ 646 WOC	
11/11	RTD 2670' Schl 5" @ 2652' Schl Her. Kr. 2472', Win 2528', Up Ft. 2596', Low Ft. 2652'.	
11/18	CO 2670 Frac 144/ 2472-96 48/ 2502-10 96/ 2528-44 24/ 2548-52 48/ 2558-66 192/ 2598-2630 Frac.	
12/2	Spud 11-1-53 Gas well TD 2670' 8" @ 646 Her. 2472' Win. 2528' Ft. Riley 2596' TD 2670' 5" @ 2652 CO to 2670 frac 144/2472-96 48/2502-10 96/2528-44 24/2548-52 48/2558-66 192/2598-2630 frac. Comp. 8,226,000 gas. 370#	

COMPLETED

