


Hamilton

KANSAS

SECTION 21 TOWNSHIP 26S RANGE 43W

WELL NO. #1 Hatcher

COMPANY Skelly

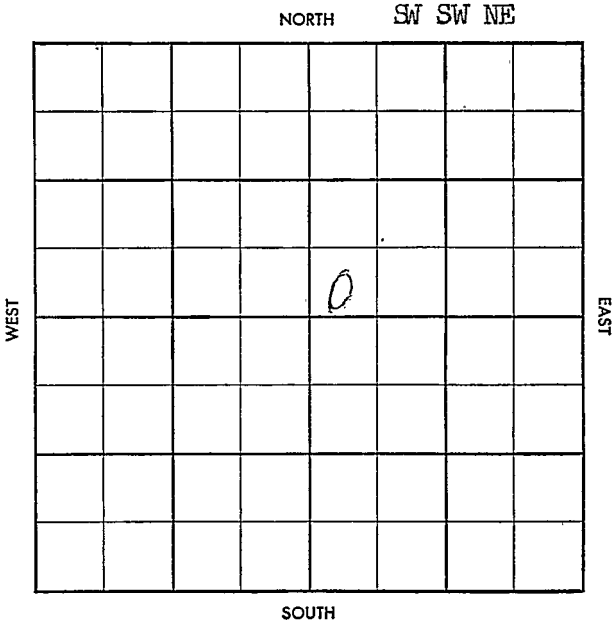

# WILDCAT

S-513-A

CO. Hartsville ELEV. \_\_\_\_\_  
 SEC. 21 TWP. 26 RGE. 43 W  
 COMPANY Stelly NO. 1

| FIRST REPORT |    |  |  |
|--------------|----|--|--|
| NOV 6        | 57 |  |  |
|              | 0  |  |  |
|              |    |  |  |
|              |    |  |  |

FARM hatcher Phillips DHM

LOC. SW SW NE

|  |  |
|--|--|
|  |  |
|  |  |
|  |  |
|  |  |
|  |  |
|  |  |
|  |  |
|  |  |
|  |  |

GEOL. \_\_\_\_\_  
 CONTR Sterling Com  
 POOL Wildcat  
 SPUD \_\_\_\_\_  
Miss. Test.

LSE. NO. SEC. TWP. RGE.

CO. 1 ELEV. 35850  
 SEC. 1 TWP. 2 RGE. W  
 COMPANY 21122 NO. 7

DEC 18 57

ABANDONED

FARM

LOC.

GEOL.

CONTR.

POOL

SPUD 11-16-57

8 1/2 1788/550

WOL Council

Grade 2558

DST 3232-338

60" 2' M FP 20-22

BHP 640/20" 3480  
 Admin 2814 TP 3467 HB  
 3712 L24 3825 Marm 4310  
 FC 4511 4728 MOV  
 74 5036 Purdy 5058  
 DST 5054-90 60" 20' M  
 FP 35-40 BHP 720 1.0"  
 5-94 Keys 5334.6  
 DST 5330-72 60" 130' M  
 410' SW FP 225 5' 4 410.2'

L Keys 5414-37 DST 5397  
 - 5450 60" 105' M FP 25-80  
 BHP 1070/20" Miss 5435 DST  
 5450-5510 60" 40' M FP  
 10-10 BHP 640/20" ~~FD 5570?~~  
 DST 5540-75 60"  
 10' M FF 0 BHP 220/20"  
 TP 5640 Log DST  
 5575 5640 60" 90' M  
 2140 29 CSW FP 550-1370  
 BHP 130/20" Log + 20 Admin  
 2815 TP 3442 HB 3704  
 L24 3824 Marm 4310 CE  
 4520 Marm 2260 Purdy  
 5076 "G" 51 5315 11 Keys  
 5349 L Keys 5427  
 ST 22 5437

p14