


DX 78-1 Finney

KANSAS

Section 21 Township 26 Range 33W

Well No. #1 Knapp

Company Northern Natural Gas

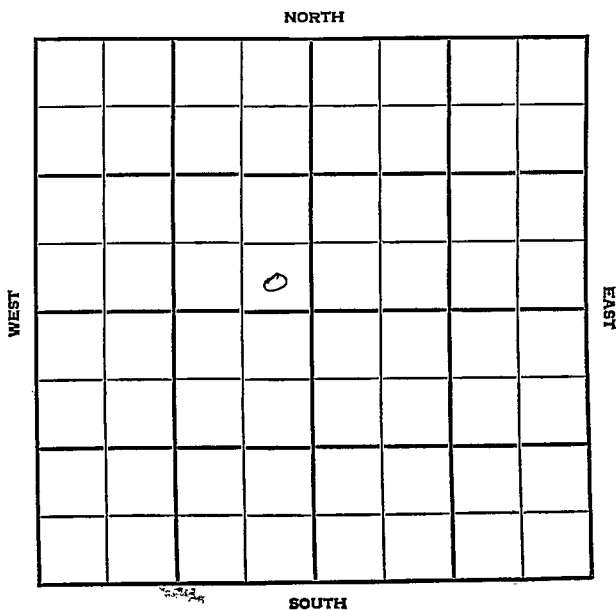

SEC. 21	TWP. 26	R. 33W
------------	------------	-----------

WELL NO.

#1 Knapp

FARM

COMPANY

Northern Natural Gas

CONTRACTOR

Hugoton


_____ FT. FROM N. LINE

_____ FT. FROM S. LINE

_____ FT. FROM E. LINE

_____ FT. FROM W. LINE

SE SE NW

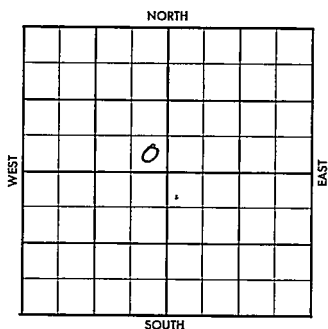

1956	ELEVATION 2927'	REPORT
------	--------------------	--------

6-6 Location

8-29 ~~#####~~ 8 5/8" @ 528 w/275

5 1/2" @ 2747 w/600

CO 2724- 32/2712-20, 12 hrs.

BD 237 MCF; 16/2654-58; 32/2666-24;

18 hrs.; BD 520 MCF; 64/2598-2614;

60/2622-37; 18 hrs.

BD 1.540 MCF; Frac;

3.463 MCF; 64/2598-2614; 18 hrs.

BD 1.540 MCF; 3.463 MCF

72-20 7.925 MCF; SIP 390#.

Log tops:

Kri. 2595'; Herr. 2570'; Wfd. 2652';

Ft. Rly 2710';

TD 2755'

COMPLETED

County Finney Elev. _____
 Sec. 27 Twp. 26 Rge. 33W
 Company Northern Natural Gas
 Farm Name Knapp No. 1

TOPS	DEPTH	LOG	DATUM
Anb.			
TP.			
H.			
Tr.			
Dg.			
Bl.			
L.			
K.C.			
B.K.C.			
Ce.			
C.			
M.			
M.			
K.			
Mz.			
Mq.			
V.			
S.			
S.			
A.			
R.			
PE.			
G.			
T.D.			

Loc. in Sec. SE SE NW

Geol. _____

Contr. _____

Pool Hugoton

FIRST REPORT
 0
 JUN 6 '36

Date Comm. _____

Location _____

JUN 1 1936

R. P.

[Handwritten signature]

Co.
Lse.
No.
Sec.
T.
R.

County Finney Elev. 2927
 Sec. 27 Twp. 26 Rge. 33W
 Company Northern Natural Gas
 Farm Name Knapp No. 1

TOPS	DEPTH	LOG	DATUM	Loc. in Sec.
Ant. <u>Herr</u>		<u>2572</u>		SE SE NW
Ce.				
C.				
M.				
M.				Pool
K.				<u>Huron</u>
Me.				
Mo.				
V.				
S.				
S.				
A.				
R.				
PE.				
G.				
TD	<u>2755</u>	<u>2760</u>		

COMPLETE

Date Comm. AUG 29 1956

Location JUN 13 '56 JUN 20 '56 LOC. JUN 27 '56
JUL 3 '56 JUL 11 '56 JUL 18 '56 537 JUL 25 '56
8 5/8 528/275 AUG 1 '56 2710
AUG 8 '56 5 1/2 2747/600
AUG 15 '56 CO 2724 32/2712-20 A
12 hr BD 237 MCF 16/2654
-58 32/2666-74 A 18 hr
BD 520 MCF 64/2598-2614
60/2622-37 A 18 hr BD 1,540 MCF

FVAC 3,463 MCF (A) 64/2598
-2614 (A) 18 hr BD 1,540 MCF
FRAC 3,463 MCF (A) AUG 22 '56
72-20 7,925 MCF SIP
390 AUG 29 '56

21-26.33 De. de. m. m.