

Ford

KANSAS

25

26

23W

SECTION _____ TOWNSHIP _____ RANGE _____

WELL NO. #1 Nau

COMPANY Colorado O&G

		NORTH		NE		NW		SW			
WEST											
		0									
		SOUTH									

Ford

KANSAS

SEC.

TWP.

R.

25

26 S

23 W

WELL NO.

1 Nau

FARM

COMPANY

Colorado O & G

CONTRACTOR

Wildcat


____ FT. FROM N. LINE

____ FT. FROM S. LINE

____ FT. FROM E. LINE

____ FT. FROM W. LINE

NE NW SW

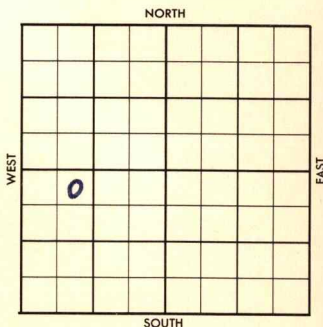

SDX-3/4 Mile

1957

ELEVATION

REPORT

3/20

Location

(FR Tkt)

2428 DF

County Form Elev. 2431 KB
 Sec. 25 Twp. 26 Rgn. 23W
 Company Colorado O & G
 Farm Name Nau No. 1

TOPS	DEPTH	LOG	DATUM	Loc. in Sec.
Anh.				NE 1/4 34
TP				
U.F.P. 1A	2720			
	4128			
	1270			
B.L. Mart	4580			Bob Atkinson
Ce.	4806			Geol.
C.				Contr. Lewis #4
M.	4935			
M.				Pool
K.				of Locat
Mz.	5220			
Me.				
V.				
S.				
S.				
A.				
R.				
Pe.				
G.				
TD.	5259			

ABANDONED

Date Comm.

Location APR 27 '57 RUR APR 3 '57

3-23-57 878 @ 516 / 300
DST 2612-33 2 hrs. net 40'
Md FP 0-35 BHP 510/30
~~17-22~~ DST 2784-2801 90"
75' Md FP 0-40 BHP 435
17-2860 APR 10 '57 17-4230 APR 17 '57
SD @ 4240 Lost Bit. APR 24 '57
Fishing MAY 1 '57 17-4370 MAY 8 '57

DST 4506-28 op. 2 hrs
net 1100' MSW FP 0-460
BHP 1450/30" DST 4937
-95 2 hrs net 1080' MSW
GC Wtr FP 30-550
BHP 1460/30" D. @ 5072
MAY 15 '57 DST 5016-32 1 hr
net 20' SWCM BHP 1500/30

D.E.A.

25-26-23

ne net out

WILDCAT

FORM 513 SUNRAY

County Fort Elev. _____
 Sec. 25 Twp. 26 Rge. 23W
 Company Colorado O & G
 Farm Name Nau No. 1

TOPS

DEPTH

LOG

DATUM

Loc. in Sec.

Anh.

NE NW SW

TP.

H.

Tr.

Dg.

BL.

L.

K.C.

Geol.

B.K.C.

Contr.

Ce.

C.

M.

M.

K.

Pool

Mz.

Wildcat

Ma.

V.

S.

S.

A.

R.

Pe.

G.

T.D.

FIRST REPORT

Date Comm.

Location

3/4 mile ~~SW~~ ^{SE}

24

COPIES MADE

M.M.