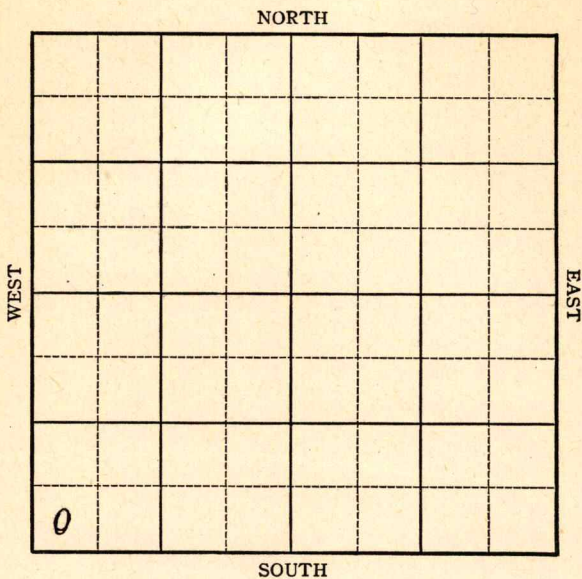


Section 4 Township 26 Range 23WWell No. 1 BrownCompany Ed Swearer et al

KANSAS

Ford County

Sec. 4 Twp. 26 R. 23W

Well No. #1 Brown Farm

Ed Swearer Company

Wildcat


 Ft. from N. Line

330 Ft. from S. Line

 Ft. from E. Line

330 Ft. from W. Line

SW/c

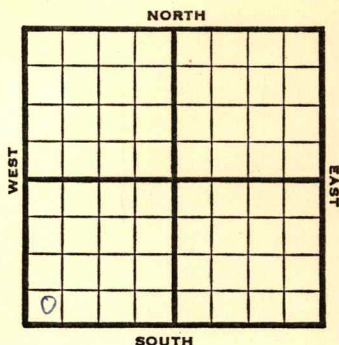

1946 **Elev. 2495** **REPORT**

4/24 RUR

5/1 10" @ 240
Dakota 490
Blaine 995
Drlg 1700'

5/7 **Anhy 1578**
Holenber 2548
Winfield 2648
Ft Riley 2721
Herington 2612
TD 2227
8" @ 2722 RUST

5/15 **Ft. Riley 2721**
8" @ 2722
10 shots 2653-2683
TD 2915'

ABANDONED

O.W.D.D

1946

5/29 D&D 2905
8" @ 2722
Drlg. 3000'

OVER

1946

6/5 Drlg. 3625'
6/12 Topeka 4035
Lans 4251'
Drlg 4517'
6/18 Miss 4964
Drlg 5088'
6/26 Drlg 5520'
7/3 Simp. 5658
Arb. 5698
TD 5785'

ABANDONED

KANSASKansas Pool Name WildcatMap No. 86 Sec. 4 Twp. 26 R. 23WWell No. 1 BrownEd Swearer et al

Company

ABANDONED

Contractor

SW/C

E1.2495**SECTION PLAT**

Ft. from N. Line330Ft. from S. LineFt. from E. Line330Ft. from W. LineFord County

Location _____

Rig up _____

Drilling and Remarks:

Simple 5658
Cor 5698

RECORD

Cased _____ in., _____ ft.

Sand _____

Gas _____

Oil _____

Total Depth 5285**PRODUCTION**

1st 24 hrs. Nat. _____

1st 24 hrs. after shot _____

Gas _____ Cu. Ft.

Dry Hole _____

Abandoned _____

Date

JUL 3 1946 19S. J. LEWIS

Scout

Kansas Pool Name WildcatMap No. 86 Sec. 4 Twp. 26 R. 23WWell No. 1 BrownEd Swearer et al CompanyFIRST REPORT

Contractor

SW/C

SECTION PLAT

 Ft. from N. Line330 Ft. from S. Line Ft. from E. Line330 Ft. from W. Line

Ford CountyOWDDLocation Rig up

Drilling and Remarks:

D&D 29058" @ 27223000'

RECORD

Cased in., ft.Sand Gas Oil Total Depth

PRODUCTION

1st 24 hrs. Nat. 1st 24 hrs. after shot Gas Cu. Ft.Dry Hole Abandoned

Date

MAY 29 194619S. J. LEWIS

Scout

KANSAS

Kansas Pool Name WildcatMap No. 83 Sec. 4 Twp. 26 R. 23WWell No. 1 BrownEd Swearer


Company

FIRST REPORT

Contractor

SW/C

SECTION PLAT

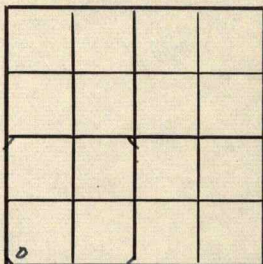 Ft. from N. Line330 Ft. from S. Line Ft. from E. Line330 Ft. from W. LineFord CountyLocation Rig up

Drilling and Remarks:

R U R

RECORD

Cased in., ft.Sand Gas Oil Total Depth

PRODUCTION

1st 24 hrs. Nat. 1st 24 hrs. after shot Gas Cu. Ft.Dry Hole Abandoned

Date

APR 24 1946 19

S. J. LEWIS Scout

KANSASKansas Pool Name WildcatMap No. 86 Sec. 4 Twp. 26 R. 23WWell No. 1 Brown

Ed Swearer

Company

ABANDONED

Contractor

SW/C

L12495**SECTION PLAT**

0			

 Ft. from N. Line330 Ft. from S. Line Ft. from E. Line330 Ft. from W. LineFord CountyLocation Rig up

Drilling and Remarks:

At Riley 2721
8" @ 2722
10 shots to 2653-2683

RECORDCased in., ft.Sand Gas Oil Total Depth 2915**PRODUCTION**1st 24 hrs. Nat. 1st 24 hrs. after shot Gas Cu. Ft.Dry Hole Abandoned

Date

MAY 15 1946 19S. J. LEWIS Scout