


Section 23 Township 26 Range 39WWell No. #1 McDonald Gas Unit "D"Company Stanolind

NORTH

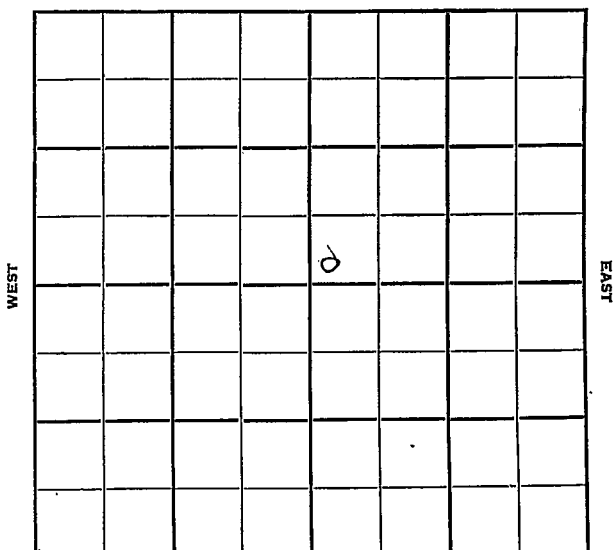

SOUTH

Sec. 23 Twp. 26 R. 39W

Well No. #1 McDonald Gas Unit "D" Farm

Stanolind Company

Hugoton Pool Contractor

Ft. from N. Line

150


Ft. from S. Line

Ft. from E. Line

150

Ft. from W. Line

SW NE

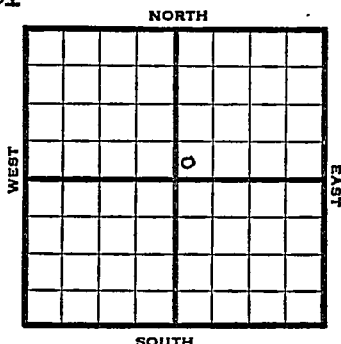

1952

Elev. 3321' REPORT

7/30

Location

8/6

"

8/13

10" @ 652'

Her Krider 2475 Winfield 2530

Towanda 2600 Ft. Riley 2647

RTD 2682 5" @ 2647'

8/20

CO 2682 2500 A 26/2477-81

12/2484-86 24/2488-92

24/2497-2501 66/2509-20

24/2530-34 36/2540-46

24/2548-52 24/2558-62

30/2575-80 36/2582-88

30/2601-06 42/2610-17

12/2620-22 66/2630-41

28,000 A

8/27

Spud 8-3-52 Gas Well TD 2682'

10" @ 652' 5" @ 2647 TD 2682

Her. Kri 2475 Win 2530

Towanda 2600 Ft. Riley 2647

CO to 2682

26/ 2477-81 12/ 2484-86

24/ 2488-92 24/ 2497-2501

66/ 2509-20 24/ 2530-34

36/ 2540-46 24/ 2548-52

24/ 2558-62 30/ 2575-80

36/ 2582-88 30/ 2601-06

42/ 2610-17 12/ 2620-22

66/ 2630-41 20000 A

Comp. 18,755,000 gas 410#

COMPLETED

County **Hamilton** State **Kansas**

Sec. **23** (Blk. Twp.) **26** (Sur. Rge.) **39W** Map No.

Operator **Stanolind**

Well No. 1 Farm McDonald Gas Unit "D"

| Elev. | Location | SW | NE |
|-------|----------|----|----|
|-------|----------|----|----|

|  |  |  |  |  |  |
|--|--|--|--|--|--|
|  |  |  |  |  |  |
|  |  |  |  |  |  |
0

FIRST REPORT

150 Ft. From S Line NE

150 Ft. From W Line Quarter

1st. Report JUL 3 0 1952


### Completion

Remarks

Spudding Date \_\_\_\_\_

Drlg. Data                      Hugoten Pool

Location

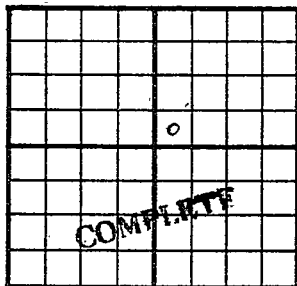County Hamilton State KansasSec. 23 (Blk. Twp.) 26 (Sur. Rge.) 39W Map No.Operator StanolindWell No. 1 Farm McDonald Gas Unit "D"Elev. 3321 Location SW NE150 Ft. From S Line NE150 Ft. From W Line Quarter

1st. Report

Completion AUG 27 1952Remarks Hugoton PoolSpudding Date 8-3-52Drlg. Data Gas well TD 268210" @ 652 5" @ 2647 TD 2682Her-Kri. 2475 Win. 2530 Towanda 2600Ft. Riley 2647 CO to 2682 26/ 2477-8112/ 2484-86 24/ 2488-92 24/ 2497-250166/ 2509-20 24/ 2530-34 36/ 2540-4624/ 2548-52 24/ 2558-62 30/ 2575-8036/ 2582-88 30/ 2601-06 42/ 2610-1712/ 2620-22 66/ 2630-41 20000 AComp 18,755,000 gas 410#