

KANSAS


FORM 51 IOM 12-46 PETROL

Hamilton county

Section 23 Township 26 Range 40-W

Well No. #1, Lahmeyer

Company Stanolind Oil and Gas Company

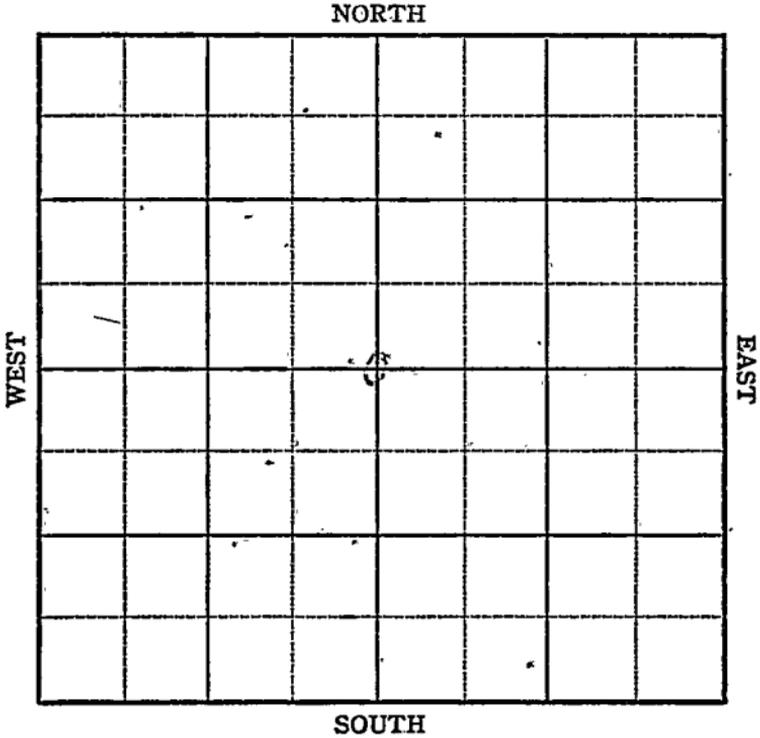

Sec. 23 Twp. 26 R. 40W

Well No. #1, Lahmeyer Farm _____


Stanolind Oil and Gas Co. Company
Hugoton Pool

2640' Ft. from N. Line

_____ Ft. from S. Line

2640' Ft. from E. Line

_____ Ft. from W. Line

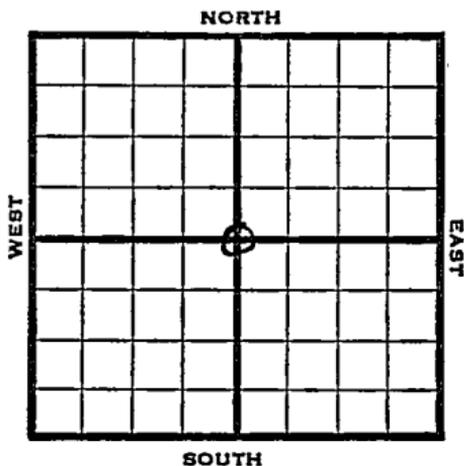

C section

1946 Elev. 3368 **REPORT**

12/11 Drlg. 340'

12/17 8" @ 647'
Drlg 2452'

1947

1/4 TD 2692
5" @ 2661'
3000 acid;
Plug 2650
144 shots 2610-34

1/8 2500 acid W Plug 2590'
144 shots 2550-74, 500 acid

1/15 5" @ 2661'
TD 2692'

ABANDONED

Map No. _____ Sec. 23 Twp. 26 R. 40W

Well No. 1 Lahmeyer

Stanolind Company

FIRST REPORT Contractor

C Sec.

SECTION PLAT

2640 Ft. from N. Line

_____ Ft. from S. Line

2640 Ft. from E. Line

_____ Ft. from W. Line

Hamilton County

RECORD

Location _____

Cased _____ in., _____ ft.

Rig up _____

Sand _____

Drilling and Remarks: _____

Gas _____

drlg. 340

Oil _____

Total Depth _____

PRODUCTION

1st 24 hrs. Nat. _____

1st 24 hrs. after shot _____

Gas _____ Cu. Ft.

Dry Hole _____

Abandoned _____

Date

DEC 1 1 1946

19

S. J. LEWIS Scout

Map No. _____ Sec. 23 Twp. 26 R. 40W

Well No. 1 Lahmeyer

Stanolind Company

ABANDONED Contractor

C Sec. _____

E10368
SECTION PLAT

2640 Ft. from N. Line

_____ Ft. from S. Line

2640 Ft. from E. Line

_____ Ft. from W. Line

Hamilton County

Location _____

Rig up _____

Drilling and Remarks:

5102661

RECORD

Cased _____ in., _____ ft.

Sand _____

Gas _____

Oil _____

Total Depth 2692

PRODUCTION

1st 24 hrs. Nat. _____

1st 24 hrs. after shot _____

Gas _____ Cu. Ft.

Dry Hole _____

Abandoned _____

Date

JAN 15 1947

S. I. LEWIS Scout