

KANSAS

Finney

Section 23 Township 26 Range 34WWell No. 1 BakerCompany Magnolia
Hugoton

NORTH

WEST

				6			

EAST

SOUTH

Finney KANSAS ✓

Sec. 23 Twp. 26 R. 34W

Well No. #1 Baker Farm _____

Magnolia

Company _____

Hugoton Pool


330' Ft. from N. Line

_____ Ft. from S. Line

_____ Ft. from E. Line

330' Ft. from W. Line

NW SE

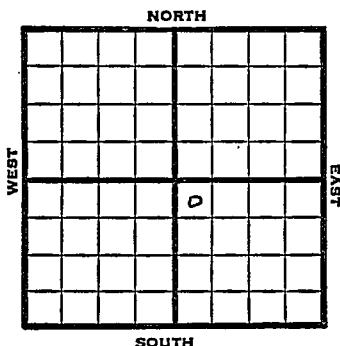

1949

Elev 2963' REPORT

9/21 10" @ 810'

TD 827'

9/28 TD 2800'

7" @ 2799'

10/5 "

10/12 "

10/19 96 shots 2700-18

7000 acid

10/26 312 shots 2546-2656

Acid 28,000

11/1 "

11/9 "

11/16 TD 2800'

7" @ 2799'

Perf

35000 acid

13,600,000 Gas

410# R Pr.

Comp

COMPLETED

Map No. _____ Sec. 23 Twp. 26 R. 34W

Well No. 1 Baker

Magnolia Company


Contractor
NW SE FIRST REPORT
SECTION PLAT

330 Ft. from N. Line

_____ Ft. from S. Line

_____ Ft. from E. Line

330 Ft. from W. Line

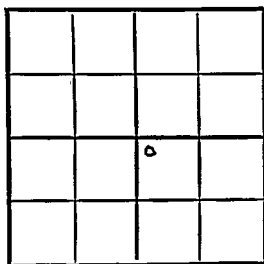

Finney County

Location _____

Rig up _____

Drilling and Remarks:

10" @ 810

TD 827

RECORD

Cased _____ in., _____ ft.

Sand _____

Gas _____

Oil _____

Total Depth _____

PRODUCTION

1st 24 hrs. Nat. _____

1st 24 hrs. after shot _____

Gas _____ Cu. Ft.

Dry Hole _____

Abandoned _____

Date

SEP 21 1949

19

S. J. LEWIS Scout

Map No. _____ Sec. 23 Twp. 26 R. 34W

Well No. 1 Baker

_____ Magnolia _____ Company

COMPLETE

Contractor

NW SE

E1.2963


SECTION PLAT

330 Ft. from N. Line

_____ Ft. from S. Line

_____ Ft. from E. Line

330 Ft. from W. Line

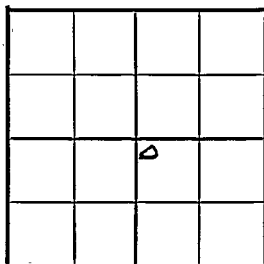

Finney County

Location _____

Rig up _____

Drilling and Remarks:

7" @ 2778

Perf

35000 acid

13,600,000 gal

4/10 # RLB

RECORD

Cased _____ in., _____ ft.

Sand _____

Gas _____

Oil _____

Total Depth 2500

PRODUCTION

1st 24 hrs. Nat. _____

1st 24 hrs. after shot _____

Gas _____ Cu. Ft.

Dry Hole _____

Abandoned _____

Date

NOV 16 1949

19

S. J. LEWIS Scout