

Kearny

FORM 51 IOM 12-46 PETROL


KANSAS

Section 23 Township 26 Range 35W

#3 Building + Loan

Well No. ~~1 Potter~~

Company Helmerich & Payne

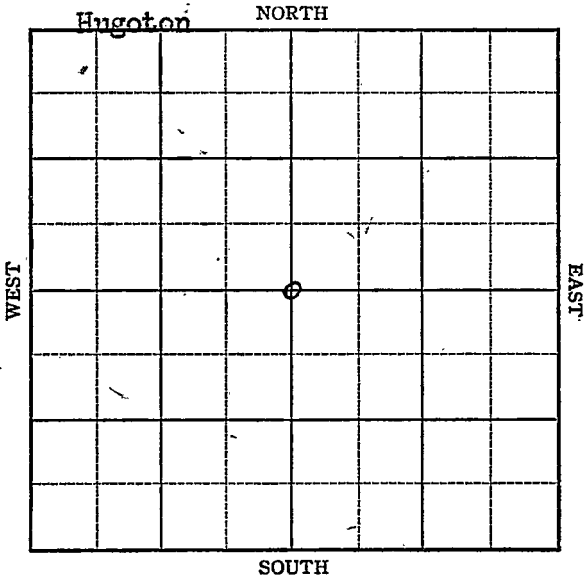

KANSAS

Kearny county ✓

23

26

35W

Sec. _____ Twp. _____ R. _____

Well No. ~~1 Potter~~ 3 *Building & Loan* Farm
Helmerich & Payne _____ Company

Hugoton Pool

2640

Ft. from N. Line


Ft. from S. Line

2640

Ft. from E. Line

Ft. from W. Line

C SEC.

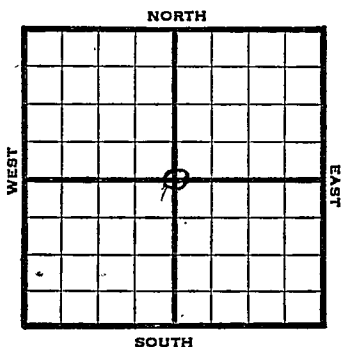

1947

Elev. 2992'

REPORT

5/7

Location

5/13

"

5/27

RUR

6/3

"

6/10

10" @ 749'
Drlg. 2410'

6/17

7" @ 2587'
TD 2600'
RUST

6/24

7" @ 2487' corrected
3500' TD

7/1

Drlg 2530'

7/8

TD 2674'
190' of 5" Perf . liner @ 2674'
12000 acid.

7/16

"

7/22

3000 acid

7/29

"

8/6

"

OVER

1947

8/13 3000' acid

8/20 " "

8/27 TD 2674'

9/3 "

9/10 TD 2674'

7" @ 2487'

190' of 5" Perf. liner @ 2674'

15,000 acid

17 M Gas

420# R. Pr.

COMPLETED

Map No. _____ Sec. 23 Twp. 26 R. 35W

Well No. 1 Potter

Helmerich & Payne Company

FIRST REPORT Contractor

C Sec.


SECTION PLAT

2640 Ft. from N. Line

_____ Ft. from S. Line

2640 Ft. from E. Line

_____ Ft. from W. Line

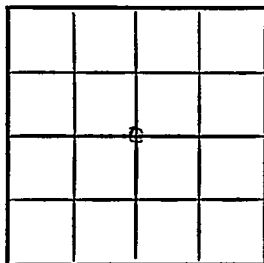

Kearny County

Location X

Rig up _____

Drilling and Remarks:

RECORD

Cased _____ in., _____ ft.

Sand _____

Gas _____

Oil _____

Total Depth _____

PRODUCTION

1st 24 hrs. Nat. _____

1st 24 hrs. after shot _____

Gas _____ Cu. Ft.

Dry Hole _____

Abandoned _____

Date

MAY 7 1947 19 _____ S. J. LEWIS Scout

no well

Small Maps	<u>6</u>
<u>3</u>	<u>14</u>
<u>2</u>	<u>1</u>
Map	<u>1</u>
rough Map	<u>X</u>
Map	<u>4</u>
ical Dept	<u>1</u>
Plat Book	<u>1</u>

Map No. _____ Sec. 23 Twp. 26 R. 35W

Well No. 3 Building & Loan


Helmerich & Payne Company

CORRECTION

Contractor

C Sec.

SECTION PLAT

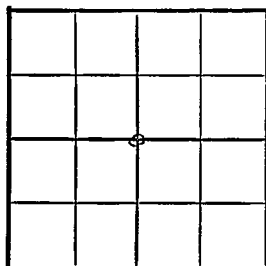

2640 Ft. from N. Line

_____ Ft. from S. Line

2640 Ft. from E. Line

_____ Ft. from W. Line

Kearny County

Location _____

Rig up _____

Drilling and Remarks:

Reported #1

Potter

RECORD

Cased _____ in., _____ ft.

Sand _____

Gas _____

Oil _____

Total Depth _____

PRODUCTION

1st 24 hrs. Nat. _____

1st 24 hrs. after shot _____

Gas _____ Cu. Ft.

Dry Hole _____

Abandoned _____

Date

MAY 28 1947 19 _____ S. J. LEWIS Scout

no wall

Misc. Small Maps	<i>2</i>
Cards	<i>24</i>
Tracing	<i>1</i>
France Map	
Scarborough Map	<i>X</i>
Pierce Map	
Geological Dept.	
Pierce Plat Book	

Map No. 0 Sec. 23 Twp. 26 R. 35W

Well No. 3 Building & Loan

Helmerich & Payne Company

COMPLETE

Contractor

C Sec.

E12992


SECTION PLAT

2640 Ft. from N. Line

_____ Ft. from S. Line

2640 Ft. from E. Line

_____ Ft. from W. Line

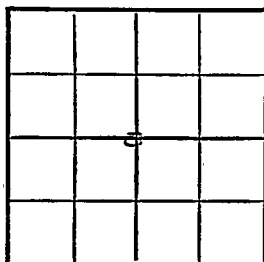

Kearny County

Location _____

Rig up _____

Drilling and Remarks:

ND 2674
7" @ 2487
190' of 5" Pay line
02674
15000 casing
1721' Gas
420# R.P.

RECORD

Cased _____ in, _____ ft.

Sand _____

Gas _____

Oil _____

Total Depth 2674

PRODUCTION

1st 24 hrs. Nat. _____

1st 24 hrs. after shot _____

Gas _____ Cu. Ft.

Dry Hole _____

Abandoned _____

Date

SEP 10 1947

19

S. J. LEWIS

Scout

check township
advice
Jan

January

Misc. Small Maps	<i>2</i>
Cards	<i>100</i>
Tracing	
France Map	<i>1</i>
Scarborough Map	<i>1</i>
Pierce Map	
Geological Dept.	
Pierce Plat Book	

Misc. Small Maps	
Cards	<i>100</i>
Tracing	
France Map	
Scarborough Map	
Pierce Map	
Geological Dept.	
Pierce Plat Book	