

Sec. 24 Twp. 26 R. 38W

Well No. #1 Eveleigh "B" Farm

Stanolind

Company

Hugoton Pool

Contractor


Ft. from N. Line

150 Ft. from S. Line

Ft. from E. Line

150 Ft. from W. Line

SW NE

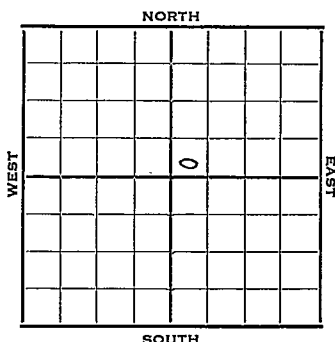

1952 Elev. 3200' REPORT

4/22 Location

4/30 Drilling

5/7 8" @ 601 TD 2665 5" @ 2633
Her 2460 Winfield 2518
Up Ft 2576 Low Ft 2632 Schl.

5/14 CO 2665 TD 2500 A 18/2462-65
78/2467-80 12/2482-84 66/2497-2508
12/2520-22 60/ 2526-36 42/ 2540-47
24/2570-74 12/ 2577-79 102/2581-98
36/2603-09 8000 A

5/21 Spud 4-24-52
Gas well TD 2665' 8" @ 601
5" @ 2633 TD 2665' Her. 2460'
Win. 2518' Ft. Riley 2576' 2500 A
18/2462-65 78/2467-80 12/2482-84
66/2497-2508 12/2520-22 60/2526-36
42/2540-47 24/2570-74 12/2577-79
102/2581-98 36/2603-09 24,000 A
Comp. 9,797,000 gas

COMPLETED

County **Kearny** State **Kansas**

Sec. 24 (Blk. Twp.) 26 (Sur. Rge.) 38W Map No.

Operator **Stanclind**

Well No. **1** Farm **Eveleigh "B"**

Elev.	3200	Location	SW NE
-------	------	----------	-------

150 Ft. From S Line NE

150 Ft. From W Line Quarter

1st. Report APR 23 1952

Completion _____

Remarks _____


Spudding Date _____

Drig. Data Hugoton Pool

Location

J. G. McGEHEE

County Kearny State Kansas
 Sec. 24 (Blk. 26 (Sur. 38W Map No.
 (Twp.) (Rge.)
 Operator Stanolind
 Well No. 1 Farm Eveleigh "B"
 Elev. 3200 Location SW NE

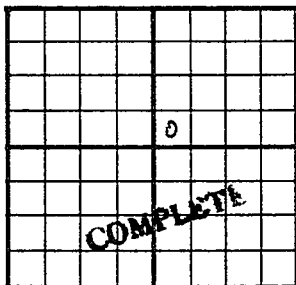

150 Ft. From S Line NE
150 Ft. From W Line Quarter
 1st. Report
 Completion MAY 21 1952
 Remarks Hugoton Pool

Spudding Date 4-24-52

Drlg. Data Gas well TD 2665

8" @ 601 5" @ 2633 TD 2665

Her. 2460 Win. 2518 Ft. Riley 2576

2500 A 18/ 2462-65 78/ 2467-80

12/ 2482-84 66/ 2497-2508 12/ 2520-22

60/ 2526-36 42/ 2540-47 24/ 2570-74

12/ 2577-79 102/ 2581-98 36/ 2603-09

24000 A Comp. 9,797,000 gas

J. G. McGEHEE