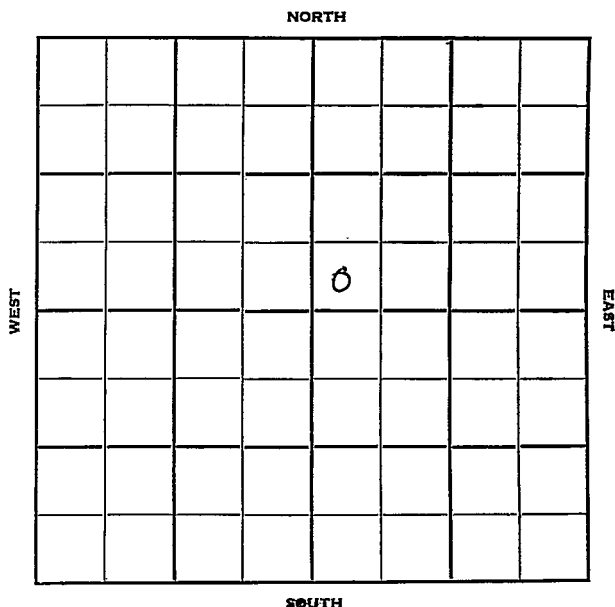


Section 24 Township 26 Range 39WWell No. #1 McDonald "E"Company Stanolind

Hamilton

KANSAS

Sec. 24 Twp. 26 R. 39W

Well No. #1 McDonald "C" Farm

Stanolind

Company

Contractor


 Ft. from N. Line

150' Ft. from S. Line

 Ft. from E. Line

150' Ft. from W. Line

SW NE

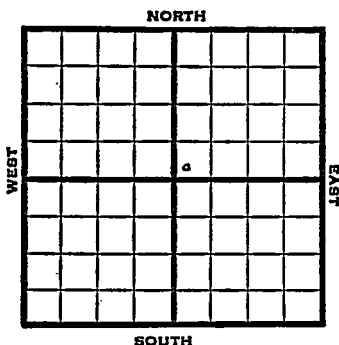

1951

Elv. 3314' REPORT

5/9
8/1

Location .
Spud 6-20-51
Gas Well TD 2720
10" @ 507 7" @ 2666 TD 2720
60/2493-2503 120/2501-21
108/2549-66 36/2574-80
36/2583-89 24/2611-15
24/2617-21 138/2622-46
17,500 A
Her. 2488 Win. 2549
Ft. Riley 2611
Comp. 18,449,000 gas
425#

COMPLETED

County **Hamilton** State **Kansas**

Sec. **24** (Blk. Twp.) **26** (Sur. Rge.) **39W** Map No.

Operator Stanolind

Well No. **1** Farm **McDonald "C"**

Elev.	Location	SW	NE
-------	----------	----	----

FIRST REPORT

150 Ft. From S Line NE

150 Ft. From W Line Quarter

1st. Report **MAY** 9 1951

Completion

Remarks


Spudding Date

Drlg. Data

Location

J. E. TYRA

County Hamilton State Kansas
 Sec. 24 (Blk. 26) (Sur. 39W) Map No.
 Operator Stanolind
 Well No. 1 Farm McDonald "C"
 Elev. 3314 Location SW NE

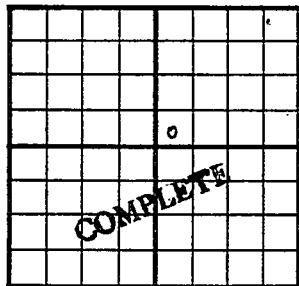

150 Ft. From S Line NE
150 Ft. From W Line Quarter

Ist. Report

Completion AUG 1 1951

Remarks

Spudding Date 6-20-51

Drlg. Data Gas well TD 2720

10" @ 507 7" @ 2666 TD 2720

60/ 2493-2503 120/ 2501-21 108/ 2549-66

36/ 2574-80 36/ 2583-89 24/ 2611-15

24/ 2617-21 138/ 2622-46 17500 A

Her. 2488 Win. 2549 Ft. Riley 2611

Comp. 18,449,000 gas 425#

J. E. TYRA