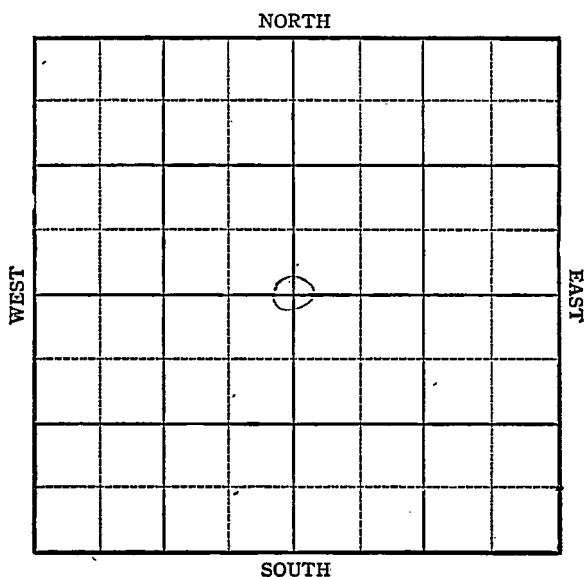


KANSAS

Kearny County

Section 24 Township 26 Range 35WWell No. #2 Citizens Bldg & LoanCompany Helmerick & Payne

KANSAS

Kearny County

Sec. 24 Twp. 26 R. 35WWell No. #2 Citizens Bldg. & Loan Farm
Helmerick & Payne Company

Hugoton


NORTH

2640 Ft. from N. Line

Ft. from S. Line

2640 Ft. from E. Line

Ft. from W. Line

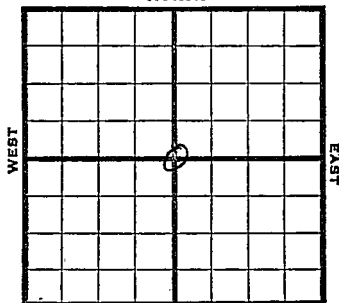

SOUTH


C Sed.

1944	ELEV. 2974 R E P O R T			
11/8	Location			
11/16	Drlg. 2700'			
11/24	10" @ 760	Drlg. 2780		
11/29	5" @ 2809	fsg.		
12/6	"	"	"	"
12/14	"	"	"	"
12/21	"	"	"	"
12/29	127 shots 2523-2773 20,500 acid.			
1945				
1/3	"	"	"	"
1/10	"	"	"	"
1/17	"	"	"	"
1/26	"	"	"	"
1/31	"	"	"	"
2/7	Squeeze perforate			
2/14	"	"		
2/21	5" @ 2809			
	20,500 acid			
	TD 2809			
	10,528,000 Gas.			
	421# R Pr.			

COMPLETED

Pool Name HugotonMap No. 1111 Sec. 24 Twp. 26 R. 35WWell No. 2 Citizens Bldg & LoanHelmerick & Payne CompanyFIRST REPORT ContractorC sec.

SECTION PLAT

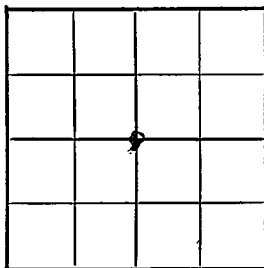2640 Ft. from N. Line Ft. from S. Line2640 Ft. from E. Line Ft. from W. LineKearnyLocation XRig up

Drilling and Remarks:

RECORD

Cased in., ft.Sand Gas Oil Total Depth

PRODUCTION

1st 24 hrs. Nat. 1st 24 hrs. after shot Gas Cu. Ft.Dry Hole Abandoned

Date

NOV 8 1944 19 S. J. LEWIS Scout

Pool Name HugotonMap No. NM Sec. 24 Twp. 26 R. 35WWell No. 2 Citizen Bldg. & LoanHelmerick & Payne


Company

COMPLETED

Contractor

C Sec.

SECTION PLAT

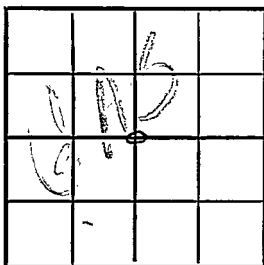2640 Ft. from N. Line Ft. from S. Line2640 Ft. from E. Line Ft. from W. Line

Kearny

RECORD

Location Rig up

Drilling and Remarks:

5' 280920,500,000 C10,528,000 Gas421# RPECased in., ft.Sand Gas Oil Total Depth 2809

PRODUCTION

1st 24 hrs. Nat. 1st 24 hrs. after shot Gas Cu. Ft.Dry Hole Abandoned

Date

FEB 21 1945 19S. J. LEWIS

Scout