

KANSAS


Kearny

Section 25 Township 26 Range 36W

Well No. 1 Loucks

Company Magnolia

Hugoton
NORTH

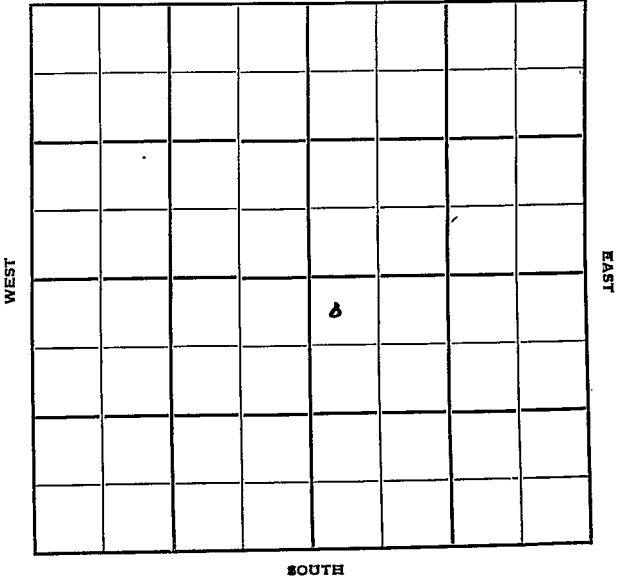

KANSAS

Kearny

Sec. 25 Twp. 26 R. 36W ✓

Well No. #1 Loucke Farm

Magnolia Company

Hugoton Pool


330' Ft. from N. Line

_____ Ft. from S. Line

_____ Ft. from E. Line

330' Ft. from W. Line

NW SE

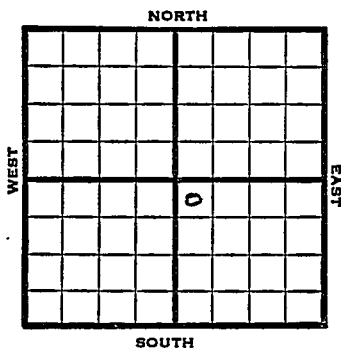

1949

Lev 3100' REPORT

- 4/13 10" @ 812'
- 4/20 6" @ 2799' TD
- 4/27 536 shots 2638-2762
Acid 21,000
- 5/4 192 shots 2576-2616 - 14000 acid
- 5/10 "
- 5/18 TD 2799'
6" @ 2799'
Perf
35000 acid
9,240,000 Gas
382# R Pr.
Comp

COMPLETED

Map No. _____ Sec. 25 Twp. 26 R. 36W

Well No. 1 Loucks

Magnolia Company

FIRST REPORT Contractor

NW SE

SECTION PLAT

330 Ft. from N. Line

_____ Ft. from S. Line

_____ Ft. from E. Line

330 Ft. from W. Line

		o	

Kearny County

Location _____

Rig up _____

Drilling and Remarks:

10" @ 812

RECORD

Cased _____ in., _____ ft.

Sand _____

Gas _____

Oil _____

Total Depth _____

PRODUCTION

1st 24 hrs. Nat. _____

1st 24 hrs. after shot _____

Gas _____ Cu. Ft.

Dry Hole _____

Abandoned _____

Date

APR 13 1949

19

S. J. LEWIS

Scout

Map No. _____ Sec. 25 Twp. 26 R. 36W

Well No. 1 Loucks

Magnolia Company

COMPLETE

Contractor

NW SE

E. 3100
SECTION PLAT

330 Ft. from N. Line

_____ Ft. from S. Line

_____ Ft. from E. Line

330 Ft. from W. Line

		6	

Kearny County

Location _____

Rig up _____

Drilling and Remarks:

6" C2799

Perf.

35000000

9,240,000 Gas

382 RR

RECORD

Cased _____ in., _____ ft.

Sand _____

Gas _____

Oil _____

Total Depth 2759

PRODUCTION

1st 24 hrs. Nat. _____

1st 24 hrs. after shot _____

Gas _____ Cu. Ft.

Dry Hole _____

Abandoned _____

Date

MAY 18 1949 19

S. J. LEWIS Scout