
FORM 51 25M 8-50 WESTERN

Hamilton KANSAS

Section 25 Township 26 Range 40W

Well No. #3 Helmes

Company United Prod.

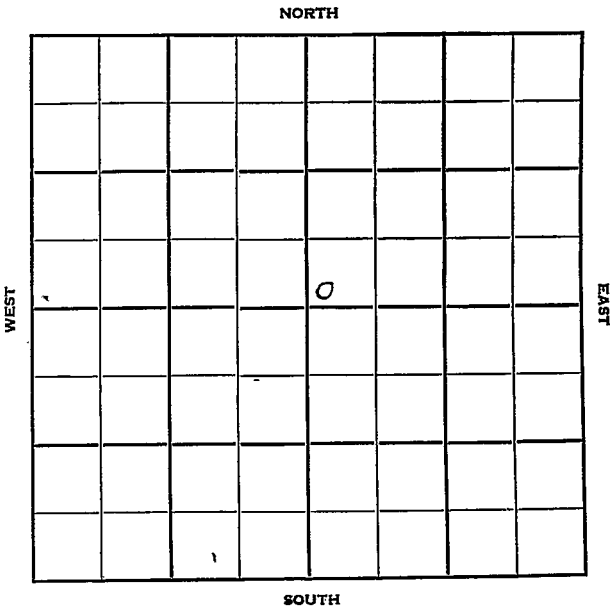

FORM 252-B
10M 10-50 PETROL

Hamilton

KANSAS

Sec. 25 Twp. 26 R. 40W

Well No. #3 Helmes Farm

United Prod. Company

Hugoton Contractor

Hugoton Gas


____ Ft. from N. Line

150 Ft. from S. Line

____ Ft. from E. Line

150 Ft. from W. Line

SW SW NE

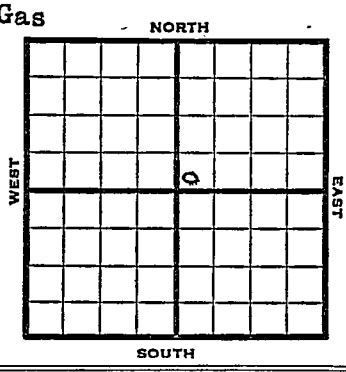

1952	REPORT
1/23	Spud 1-18-52 10" @ 461' Drlg. 1100'
2/6	TD 2456 7" @ 2442 WOC
2/13	NR
2/20	Her 2439 Krider 2449 Winfield 2483 TD 2510 2000 A NS PB 2504
3/5	5 gal SWPH 768,000 gas PB 2498 1 gal SWPH 237,000 gas 3000 A 2,148,000 gas SSSW PB 2495 Spray SW PB 2491 WOC
3/12	NR
3/19	Running liner
4/2	Spud 1-18-52 Gas Well TD 2510 10" @ 461' 7" @ 2442' TD 2456 Her. 2439 Kri 2449 Win. 2483 TD 2510 2000 A PB 2504 5 gswph 768,000 gas PB 2498 1 gswph 237,000 g 3000 A 2,148,000 gas SSW PB 2495 spray SW PB 2491 6500A Comp. 3,400,000 gas

COMPLETED

FORM 275 FOR SALE BY KANSAS BLUE PRINT CO.


County Hamilton State Kansas

Sec. 25 (Blk. Twp.) 26 (Sur. Rge.) 40W Map No.

Operator United Prod.

Well No. 3 Farm Helmes

Elev. Location SW SW NE

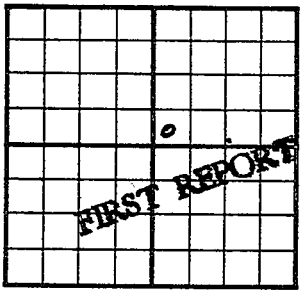

150 Ft. From S Line NE

150 Ft. From W Line Quarter

1st. Report JAN 23 1952

Completion

Remarks

Spudding Date 1-18-52

Drlg. Data Hugoton Gas

10" @ 461 Drlg. 1100

J. E. TYRA

Scout Cards .....
Land Small Map .....
Land Wall Map .....
Tracings .....
France Map .....
Pierce Map .....
Misc. .....

JAN 25 1952

Drlg. Data

FORM 275 FOR SALE BY KANSAS BLUE PRINT CO.


County Hamilton State Kansas

Sec. 25 (Blk. Twp.) 26 (Sur. Rge.) 40W Map No.

Operator United Prod.

Well No. 3 Farm Helmes

Elev. 3365 Location SW SW NE

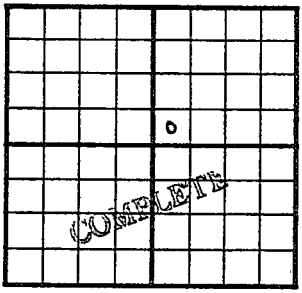

150 Ft. From S Line NE

150 Ft. From W Line Quarter

1st. Report

Completion APR 2 1952

Remarks Hugoton Pool

Spudding Date 1-18-52

Drlg. Data Gas well TD 2510

10" @ 461 7" @ 2442 TD 2456

Her. 2439 Kri. 2449 Win. 2483

TD 2510 2000 A PB 2504 5 gswph

768,000 gas PB 2498 1 gswph 237,000 g

3000 A 2,148,000 gas SSSW PB 2495

spray sw PB 2491 6500 A

Comp. 3,400,000 gas.

J. G. McGEHEE

Scout Cards
Land Small Map
Land Wall Map
Tracings
France Map
Pierce Map
Misc.

APR 8 1919

Drlg. Data