

KAS

Kearny County

FORM 51 IOM 12-46 PETROL


Section 25 Township 26 Range 35-WWell No. 4 Building & LoanCompany Helmerich & Payne

Hugoton Pool

NORTH

WEST

EAST

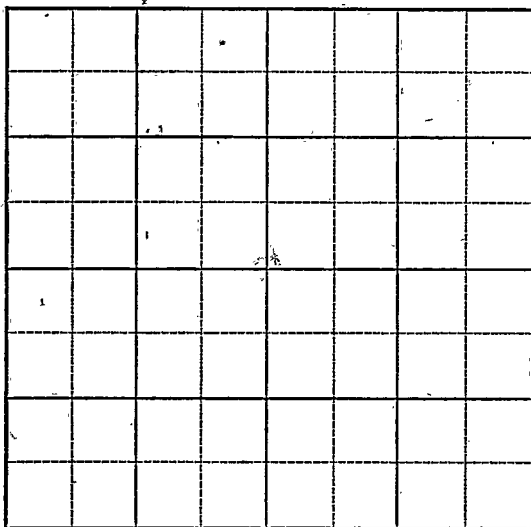

SOUTH

Sec. 25 Twp. 26 R. 35-W

Well No. #1 Building & Loan Farm

Helmerich & Payne Company


Hugoton Pool

2640 Ft. from N. Line

_____ Ft. from S. Line

2640 Ft. from E. Line

_____ Ft. from W. Line

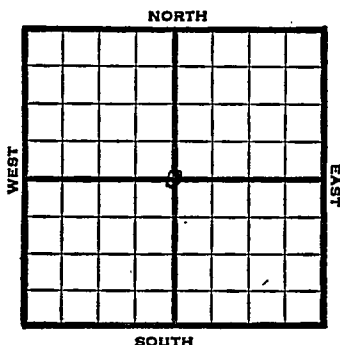

C SEC.

1947 Elev. 3001' REPORT

7/9	R U R
7/16	10" @ 760' Drlg 1850'
7/22	TD 2506 7" @ 2505 RUST
7/29	T.D. 2732' 229' of 5' Perf. Unier. C. 2732' 7300' Acid
8/6	2000 acid.
8/13	" "
8/20	" "
8/27	" "
9/3	" "
9/10	" "
9/17	" "
9/24	" "
10/1	" "

OVER

1947

10/8 7" @ 2505'
229' of 5" Perf liner
@ 2732
15,000 Acid
4,447,000 Gas
TD 2732'
416# R Pr

COMPLETED

Map No. _____ Sec. 25 Twp. 26 R. 35W

Well No. 4 Building & Loan

Helmerich & Payne Company

FIRST REPORT

Contractor

C Sec.


SECTION PLAT

2640 Ft. from N. Line

_____ Ft. from S. Line

2640 Ft. from E. Line

_____ Ft. from W. Line

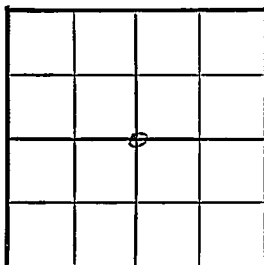

Kearny County

Location _____

Rig up _____

Drilling and Remarks:

R U R

RECORD

Cased _____ in., _____ ft.

Sand _____

Gas _____

Oil _____

Total Depth _____

PRODUCTION

1st 24 hrs. Nat. _____

1st 24 hrs. after shot _____

Gas _____ Cu. Ft.

Dry Hole _____

Abandoned _____

Date

JUL 9 1947 19

S. J. LEWIS Scout

Misc. Small Maps

Cards

Tracing

France Map

Scarborough Map

Pierce Map

Geological Dept.

Pierce Plot Book

Map No. 0 Sec. 25 Twp. 26 R. 35W

Well No. 4 Building & Loan

Helmerich & Payne Company

COMPLETE

Contractor

C Sec.


E1,3001
SECTION PLAT

2640 Ft. from N. Line

_____ Ft. from S. Line

2640 Ft. from E. Line

_____ Ft. from W. Line

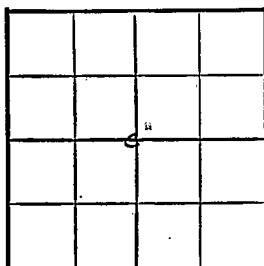

Kearny County

Location _____

Rig up _____

Drilling and Remarks:

7 1/2 2555.
228' of 5" Prof line
@ 5732.
15000 acs
4,447,000 Gas
416 # R/P

RECORD

Cased _____ in., _____ ft.

Sand _____

Gas _____

Oil _____

Total Depth 2232

PRODUCTION

1st 24 hrs. Nat. _____

1st 24 hrs. after shot _____

Gas _____ Cu. Ft.

Dry Hole _____

Abandoned _____

Date

OCT 8 1947

S. J. LEWIS

Scout




[Handwritten signature]

Misc. Small Maps

Cards *E. Laine*

Tracing

France Map


Pierce Map

Ecological Dept.

Pierce Flat Book