


Section 34 Township 26 Range 26W

Well No. #1 Kinkaid (A)

Company Deep Rock

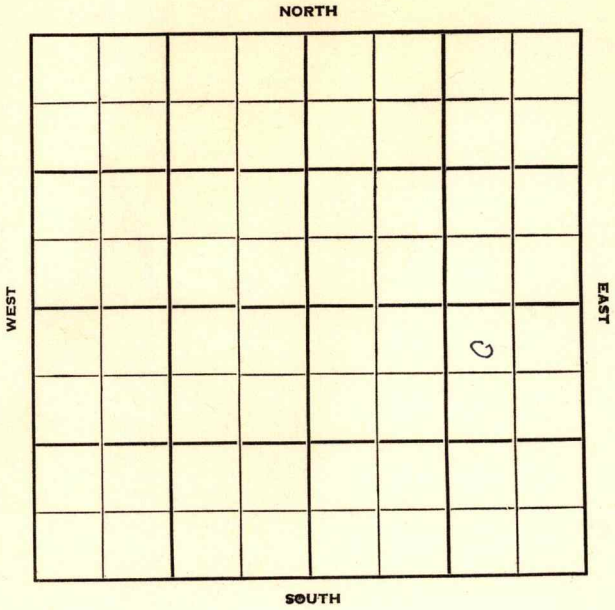

Ford

KANSAS



Sec. 34 Twp. 26 R. 26W

Well No. #1 Kinkaid (A) Farm

Deep Rock Company

Wildcat Contractor


330' Ft. from N. Line

Ft. from S. Line

990' Ft. from E. Line

Ft. from W. Line


NW NE SE

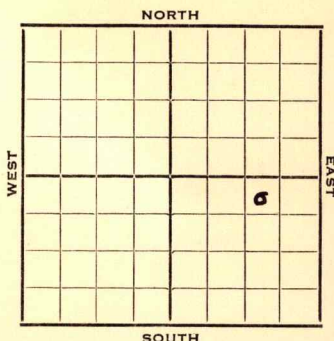

1952 Elev. 2567' REPORT

6/18 Location
6/25 13" @ 278'
7/2 Drlg. 3370'
7/9 Heeb 4154' Lans. 4291'
Drlg. 4583'
7/17 Miss 5004'
DST 5006-62, 1 hr, 2500' M 975#
Drlg. 5235'
7/23 Spud 6-22-52
D&A TD 5465' 13" @ 278'
Heeb. 4154 Lans. 4291
Miss. 5004
DST 5006-62 open 1 hr. rec. 2500' mud
975# DST 5236-81 open 1 hr. rec.
1380' sw 1575#
DST 5420-65 open 1 hr. rec. 285' sw
1500# TD 5465' D&A

ABANDONED

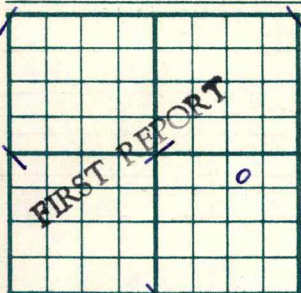County **Ford** State **Kansas**Sec. **34** (Blk.) **26** (Sur.) **26W** Map No.Operator **Deep Rock**Well No. **1** Farm **Kinkaid (A)**Elev. Location **NW NE SE****330** Ft. From **N** Line **SE****990** Ft. From **E** Line Quarter1st. Report **JUN 1 8 1952**

Completion

Remarks

Spudding Date

Drlg. Data **Wilcoat****Location**

J. G. McGEHEE

County Ford State Kansas

Sec. 34 (Blk.
Twp.) 26 (Sur.
Rge.) 26W Map No.

Operator Deep Rock

Well No. 1 Farm Kinkaid "A"

Elev. 2567 Location NW NE SE



330 Ft. From N Line SE

990 Ft. From E Line Quarter

1st. Report

Completion JUL 23 1952

Remarks Wildcat

Spudding Date 6-22-52

Drlg. Data D & A TD 5465

13" @ 278 Heeb. 4154 Lans. 4291

Miss. 5004 DST 5006-62 open 1 hr.

Rec. 2500' mud 975# DST 5236-81

open 1 hr. Rec. 1380' sw 1575#

DST. 5420-65 open 1 hr. Rec. 285' sw

1500# TD 5465

D & A

J. G. McGEHEE