


Section 26 Township 26 Range 34-W

Well No. #1 U S A "C"

Company Magnolia
Hugoton Pool

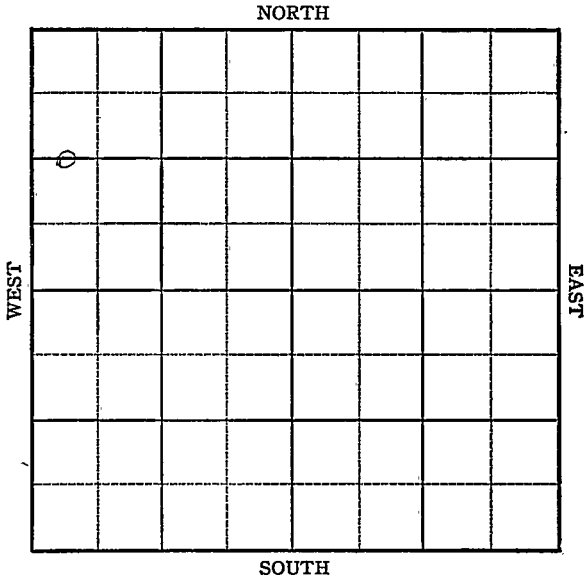

Sec. 26 - Twp. 26 R. 34W

Well No. #1 U S A "C" Farm

Magnolia Company

Contractor

Hugoton Pool


1320' Ft. from N. Line

_____ Ft. from S. Line

_____ Ft. from E. Line

330' Ft. from W. Line

C W L W $\frac{1}{2}$ NW

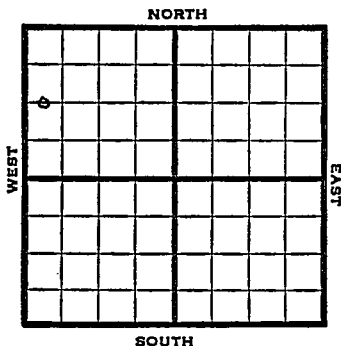

1949 Elev 2982' REPORT

11/9 10" @ 827'

Drlg. 870'

11/16 TD 2722'-95'

TD 2795'

6" @ 2792'

11/23 "

11/29 384 shots 2590-2740

38000 acid

12/7 7 shots 2564-73

7000 acid

12/14 "

12/21 TD 2795'

6" @ 2792'

Perf

45000 Acid

13,200,000 Gas

385# R Pr.

Comp

COMPLETED

Map No. _____ Sec. 26 Twp. 26 R. 34W

Well No. I U S A "C"

Magnolia Company

Contractor

C W L W $\frac{1}{2}$ NW

FIRST REPORT
SECTION PLAT

1320 Ft. from N. Line

_____ Ft. from S. Line

_____ Ft. from E. Line

330 Ft. from W. Line

Finney County

Location _____

Rig up _____

Drilling and Remarks:

10" @ 827
drlg. 870

RECORD

Cased _____ in., _____ ft.

Sand _____

Gas _____

Oil _____

Total Depth _____

PRODUCTION

1st 24 hrs. Nat. _____

1st 24 hrs. after shot _____

Gas _____ Cu. Ft.

Dry Hole _____

Abandoned _____

Date

NOV 9 1949 19

S. J. LEWIS Scout

Map No. _____ Sec. 26 Twp. 26 R. 34W

Well No. 1 U S A "C"

Magnolia _____ Company

COMPLETE

Contractor

C W L W $\frac{1}{2}$ NW

E 1,2982
SECTION PLAT

1320 Ft. from N. Line

_____ Ft. from S. Line

_____ Ft. from E. Line

330 Ft. from W. Line

Finney County

RECORD

Location _____

Cased _____ in., _____ ft.

Rig up _____

Sand _____

Drilling and Remarks:

Gas _____

6" C 2992

Oil _____

Total Depth 2785

Prof.
45000 acid
13,200,000 Gas

PRODUCTION

1st 24 hrs. Nat. _____

1st 24 hrs. after shot _____

Gas _____ Cu. Ft.

Dry Hole _____

Abandoned _____

985 R. B.

Date

DEC 21 1949

19

S. J. LEWIS

Scout