


KANSAS

Hearny

Section 27 Township 26 Range 38W
 Well No. #1 McMichael
 Company Stanolind

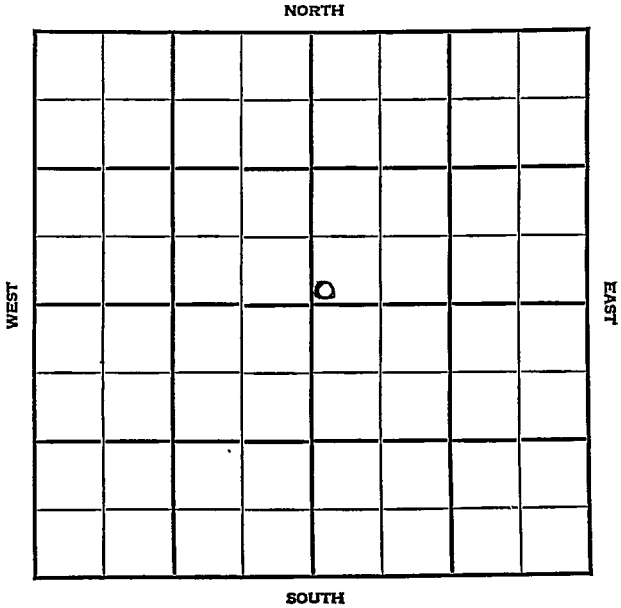

KANSAS

Kearny

Sec. 27 Twp. 26 R. 38W

Well No. #1 McMichael Farm
Stanolind Company

SW NE

 Ft. from N. Line

150'


 Ft. from S. Line

 Ft. from E. Line

150'

 Ft. from W. Line

SW NE

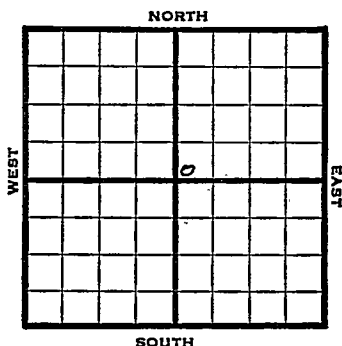

1948

E li 3191'

REPORT

6/9	10" @ 590' TD 2440' 7" @ 2406' RUST
8/16	"
6/23	"
6/29	"
7/14	TD 2618' 7"@ 2406' 223' of 5" Perf Liner @ 2618' 19,000 acid 9,965,000 Gas 410# R Pr. Comp.

COMPLETED

Map No. _____ Sec. 27 Twp. 26 R. 38W

Well No. 1 McMichael

Stanolind


Company

FIRST REPORT

Contractor

SW NE

SECTION PLAT

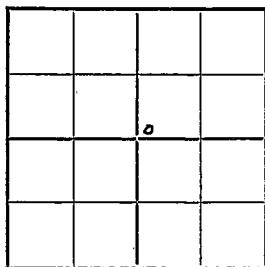

_____ Ft. from N. Line

150 Ft. from S. Line

_____ Ft. from E. Line

150 Ft. from W. Line

Kearny County

Location _____

Rig up _____

Drilling and Remarks:

10" @ 590

TD 2440

7" @ 2406 RUST

RECORD

Cased _____ in., _____ ft.

Sand _____

Gas _____

Oil _____

Total Depth _____

PRODUCTION

1st 24 hrs. Nat. _____

1st 24 hrs. after shot _____

Gas _____ Cu. Ft.

Dry Hole _____

Abandoned _____

Date

JUN 9 1948 19

S. J. LEWIS

Scout

Map No. _____ Sec. 27 Twp. 26 R. 38WWell No. 1 McMichael

_____ Stanolind et al. _____ Company

COMPLETE

_____ Contractor


SW NE

E 1/3 1/4
SECTION PLAT

_____ Ft. from N. Line

150 Ft. from S. Line

_____ Ft. from E. Line

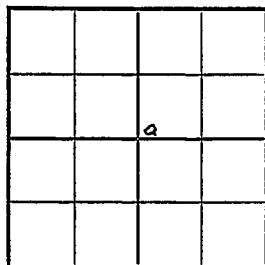150 Ft. from W. LineKearny County

Location _____

Rig up _____

Drilling and Remarks:

7" @ 2406
223' of 5" Pipe / well
@ 261819000 aad C9,865,000 gal410 # R P

RECORD

Cased _____ in., _____ ft.

Sand _____

Gas _____

Oil _____

Total Depth 2618

PRODUCTION

1st 24 hrs. Nat. _____

1st 24 hrs. after shot _____

Gas _____ Cu. Ft.

Dry Hole _____

Abandoned _____

Date

JUL 14 194819S. J. LEWISScout