

27

26

39 W

Section _____ Township _____ Range _____


1 Harry Trussell

Well No. _____

Company Stanolind Oil & Gas

NORTH

WEST

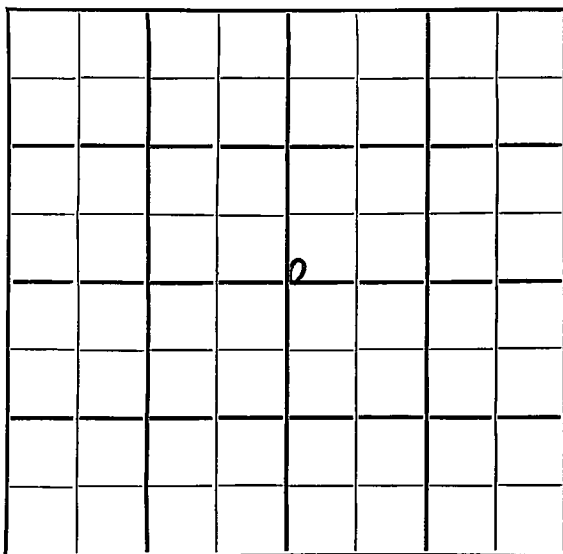

EAST

SOUTH

Hamilton

KANSAS

SEC.	TWP.	R.
27	26	39 W ✓

WELL NO.

1 Harry Trussell

FARM

COMPANY

Stanolind Oil & Gas

CONTRACTOR

Hugoton Pool


_____ Ft. from N. Line

150 _____ Ft. from S. Line

_____ Ft. from E. Line

150 _____ Ft. from W. Line

SW SW NE

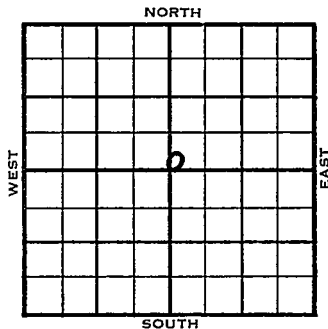

1953

ELEVATION

3284'

REPORT

10/14

Location

10/2 1

8" @ 646'

RTD 2613'

Schl

5" @ 2587'

Her. 2410', Win 2462', Up Ft. 2563,
Low Ft. 2589.

10/28

CO Testing.

11/4

Spud 10-13-53

Gas Well

TD 2613'

8" @ 646

Her. 2410', Win 2462', Ft. Riley
2536'

TD 2613'

5" @ 2587

CO to 2613 frac

60/2413-23, 24/2426-30, 24/2436-40,
126/2462-83, 78/2486-99, 120/2544-64,
42/2568-75, frac

Comp. 7,487,000 gas, 390#

COMPLETED

County Hamilton State Kansas

Sec. 27 (Blk. Twp.) 26 (Sur. Rge.) 39W Map No.

Operator Stanolind Oil & Gas

Well No. 1 Farm Harry Russell

Elev. 3284 Location SW SW NE

0

FIRST REPORT

150 Ft. From S Line NE

750 Ft. From W Line Quarter

1st. Report OCT 14 1953

Completion

Remarks

Spudding Date _____

Drlg. Data	Hugoton Pool
------------	--------------

Location

J. G. McGEHEE

J. G. McGEHEE