


KANSAS Kearny

FORM 51 IOM 12-46 PETROL

Section 27 Township 26 Range 35-W

Well No. 5 Bldg & Loan

Company Helmerich & Payne
Hugoton

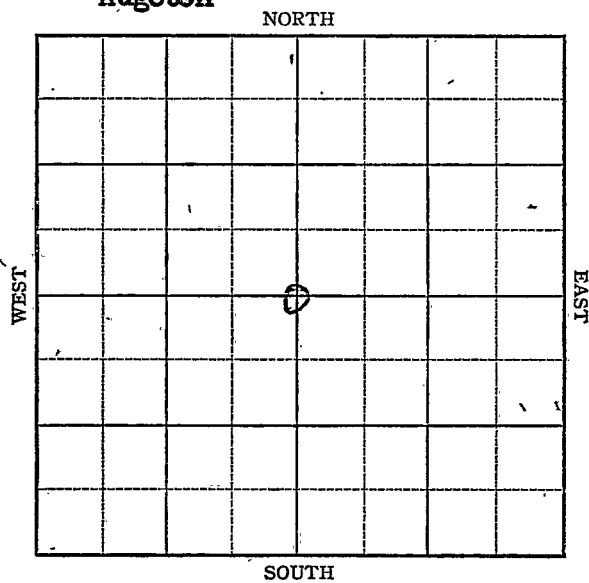

KANSAS

Kearny County ✓

Sec. 27 - Twp. 26 R. 35-W

Well No. 5 Bldg. & Loan Farm

Helmerich & Payne Company


Hugoton Pool

2640 Ft. from N. Line

_____ Ft. from S. Line

2640 Ft. from E. Line

_____ Ft. from W. Line

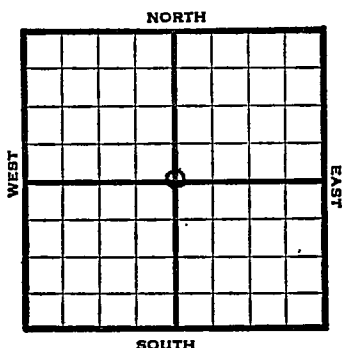

C Sec.

1947

REPORT

8/20	7" @ 2525' TD 2615 3000 acid
8/27	TD 2763' 1000 acid.
9/3	"
9/10	15000 Acid
9/17	"
9/24	2758 of 5" Perf. liner @ 2763'
10/1	TD 2770' 15,000 Acid
10/8	7" @ 2513 275' of 5# Perf liner @ 2763 31,000 Acid 1,277,000 Gas TD 2768' 425# R Pr

COMPLETED

Map No. _____ Sec. 27 Twp. 26 R. 35WWell No. 5. Bldg. & Loan

_____ Helmerich & Payne _____ Company

FIRST REPORT

Contractor

C Sec.


SECTION PLAT

2640 Ft. from N. Line

_____ Ft. from S. Line

2640 Ft. from E. Line

_____ Ft. from W. Line

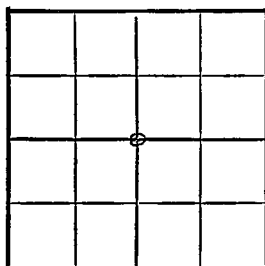

Kearny County

Location _____

Rig up _____

Drilling and Remarks:

7" @ 2525

TD 2615

3000 acid

RECORD

Cased _____ in., _____ ft.

Sand _____

Gas _____

Oil _____

Total Depth _____

PRODUCTION

1st 24 hrs. Nat. _____

1st 24 hrs. after shot _____

Gas _____ Cu. Ft.

Dry Hole _____

Abandoned _____

Date

AUG 20 1947

19


S. J. LEWIS

Scout

Form 26 200 Bks. 10-46 Petrol
KansasMap No. 0 Sec. 27 Twp. 26 R. 35WWell No. 5 Bldg. & LoanHelmerich & Payne CompanyCOMPLETE Contractor

C Sec.

SECTION PLAT

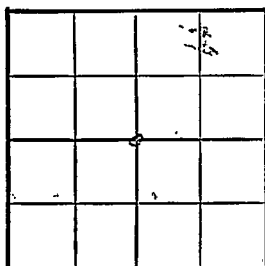2640 Ft. from N. Line Ft. from S. Line2640 Ft. from E. Line Ft. from W. Line

Kearny County

Location Rig up

Drilling and Remarks:

7" C 2573
 270' 8" / 5" Puff line
 C 2762
 81000 Rods
 1,277,000 Rods

425 # R A

RECORD

Cased in., ft.Sand Gas Oil Total Depth 2768

PRODUCTION

1st 24 hrs. Nat. 1st 24 hrs. after shot Gas Cu. Ft.Dry Hole Abandoned

Date

OCT 8 1947 19

S. J. LEWIS Scout