


Section 28 Township 26 Range 38-W

Well No. #1 Kistner "B"

Company Stanolind

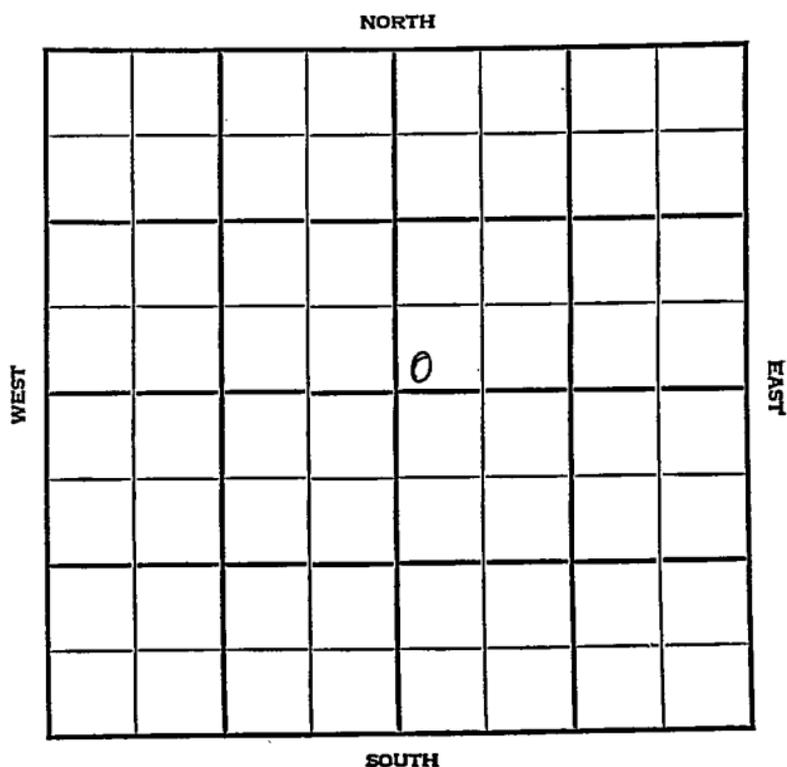

Sec. 28 KANSAS Twp. 26 R. 38W

Well No. #1 Kistner "B" Farm _____

Stanolind Company _____

Hugoton Pool


_____ Ft. from N. Line

150' Ft. from S. Line

_____ Ft. from E. Line

150' Ft. from W. Line

SW NE

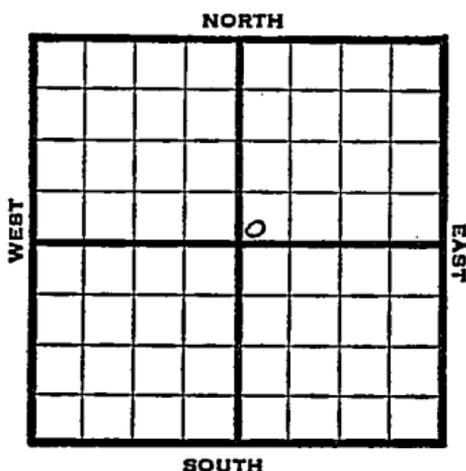

1948

Eli 3219' REPORT

7/14 10" @ 580'

7/21 TD 2440
7" @ 2409'

7/28 Drlg 2623'

8/4 7" @ 2409'
237' of 5" Perf Liner @ 2630'
16000 acid
11,139,000 Gas
420# R Pr.
Comp

COMPLETED

Map No. _____ Sec. 28 Twp. 26 R. 38W

Well No. 1 Kistner "B"

Stanolind Company

FIRST REPORT

Contractor

SW NE

SECTION PLAT

		o	

_____ Ft. from N. Line

150 Ft. from S. Line

_____ Ft. from E. Line

150 Ft. from W. Line

Kearny County

Location _____

Rig up _____

Drilling and Remarks:

10" @ 580

RECORD

Cased _____ in., _____ ft.

Sand _____

Gas _____

Oil _____

Total Depth _____

PRODUCTION

1st 24 hrs. Nat. _____

1st 24 hrs. after shot _____

Gas _____ Cu. Ft.

Dry Hole _____

Abandoned _____

Date

JUL 1 4 1948

19

S. J. LEWIS

Scout

Kearny County Kansas State

Map No. _____ Sec. 28 Twp. 26 R. 38W

Well No. 1 Kistner "B"

Stanolind Company

COMPLETE Contractor

SW NE

E1.8219
SECTION PLAT

_____ Ft. from N. Line

150 Ft. from S. Line

_____ Ft. from E. Line

150 Ft. from W. Line

Hugoton Pool

Remarks:

7" 02409
287' of 5" Prof line @ 2630
16000 acid
11,139,000 Gas
420 # R/2

Date AUG 4 1948

Scout S. J. LEWIS