

Section 28 Township 26 Range 36W

Well No. 2 Lee

Company Northern Natural Gas

Hugoton

NORTH

WEST

EAST

				0			

SOUTH

Kearny

Sec. 28 Twp. 26 R. 36W

Well No. #2 Lee Farm

Northern Natural Gas

Company


Hugoton Pool

 Ft. from N. Line

300' Ft. from S. Line

 Ft. from E. Line

300' Ft. from W. Line

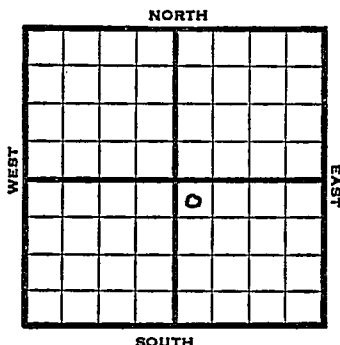

NW SE

1949	Elev 3122' REPORT
8/31	10" @ 446'
9/7	TD 2534'
9/14	7" @ 2525'
	3000 acid
	TD 2775'
9/21	260' of 5" Perf liner @ 2779'
	Acid 20,000
9/28	"
10/5	"
10/12	TD 2779'
	7" @ 2525'
	260' of 5" Perf Liner @ 2779'
	20000 acid
	14,623,000 Gas
	387# R Pr.
	Comp
	COMPLETED

Map No. _____ Sec. 28 Twp. 26 R. 36W

Well No. 2 Lee

Northern Natural Gas Company

Contractor

NW SE

FIRST REPORT
SECTION PLAT

_____ Ft. from N. Line

300 _____ Ft. from S. Line

_____ Ft. from E. Line

300 _____ Ft. from W. Line

		Δ	

Kearny County

Location _____

Rig up _____

Drilling and Remarks:

10" @ 446

RECORD

Cased _____ in., _____ ft.

Sand _____

Gas _____

Oil _____

Total Depth _____

PRODUCTION

1st 24 hrs. Nat. _____

1st 24 hrs. after shot _____

Gas _____ Cu. Ft.

Dry Hole _____

Abandoned _____

Date

AUG 31 1949 19 S. J. LEWIS Scout

Scout Cards
Land Small Map
Land Wall Map
Tracings
France Map
Map

Map No. _____ Sec. 28 Twp. 26 R. 36W

Well No. 2 Lee

Northern Natural Gas Company

COMPLETE

Contractor

NW SE

E13122
SECTION PLAT

_____ Ft. from N. Line

300 Ft. from S. Line

_____ Ft. from E. Line

300 Ft. from W. Line

		6	

Kearny County

RECORD

Location _____

Rig up _____

Drilling and Remarks:

7" @ 2525'
260' of 5" Pipe
@ 1779
20000 ac
14,623,000 Gas
887 # R.R.

Cased _____ in., _____ ft.

Sand _____

Gas _____

Oil _____

Total Depth 2775'

PRODUCTION

1st 24 hrs. Nat. _____

1st 24 hrs. after shot _____

Gas _____ Cu. Ft.

Dry Hole _____

Abandoned _____

Date

OCT 12 1949 19

S. J. LEWIS Scout

Scout Cards	Earth
Land Small Map	
Land Wall Map	
Tracings	
France Map	
Pierce Map	
Misc.	