

Company Magnolia

SOUTH

Sec. 28 Twp. 26 R. 35W

Well No. 1 Wantler Farm

Magnolia Company

Hugoton Pool


330 Ft. from N. Line

 Ft. from S. Line

 Ft. from E. Line

330 Ft. from W. Line

NW SE

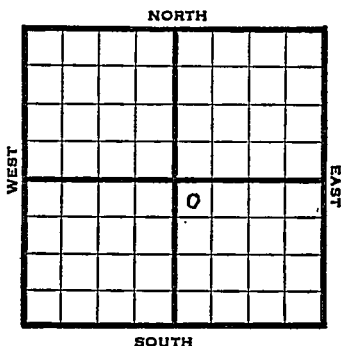

1948 Elev. 3081' REPORT

9/22 RUR

9/29 10" @ 833'
Drlg. 940'

10/6 "

10/13 "

10/19 72 shots 2640-54 7000 acid
120 " 2610-33 " "

10/20 "

11/3 7" @ 2844'
Perf
Acid 35,000
22 M Gas
R Pr. 407#
TD 2845'

COMPLETED

Kearny County Kansas StateMap No. _____ Sec. 28 Twp. 26 R. 35WWell No. 1 WantlerMagnolia CompanyFIRST REPORT Contractor

NW SE

SECTION PLAT

330 Ft. from N. Line Ft. from S. Line Ft. from E. Line330 Ft. from W. Line

Hugoton Pool

Remarks:

R U R

Date
SEP 22 1948Scout
S. J. LEWIS

Map No. _____ Sec. 28 Twp. 26 R. 35W

Well No. 1 Wantler

Magnolia Company

COMPLETE

Contractor

NW SE


E 13081
SECTION PLAT

330 Ft. from N. Line

_____ Ft. from S. Line

_____ Ft. from E. Line

330 Ft. from W. Line

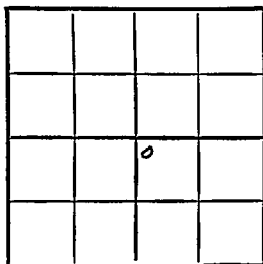

Kearny County

RECORD

Location _____

Cased _____ in., _____ ft.

Rig up _____

Sand _____

Drilling and Remarks:

Gas _____

7" C2844

Oil _____

Total Depth 2845'

Perf.
35000 cu. ft.

PRODUCTION

22 M Gas

1st 24 hrs. Nat. _____

1st 24 hrs. after shot _____

Gas _____ Cu. Ft.

Dry Hole _____

Abandoned _____

HD7 * R.R.

Date

NOV 3 1948 19

S. J. LEWIS

Scout