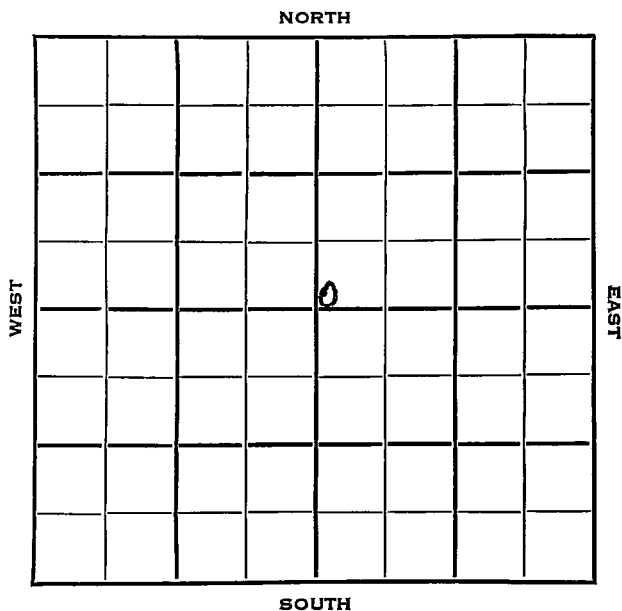


Section 29 Township 26 Range 39 WWell No. # 1 Trussel Gas Unit "D"Company Stanolind

Hamilton KANSAS

SEC. 29	TWP. 26	R. 39 W
------------	------------	------------

WELL NO.

1 Trussel Gas Unit "D"

FARM

COMPANY

Stanolind

CONTRACTOR

Hugoton Pool


Ft. from N. Line

150 Ft. from S. Line

Ft. from E. Line

150 Ft. from W. Line

SW SW NE

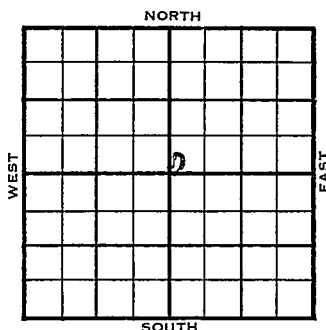

1953

ELEVATION

3300'

REPORT

11/18

Location

12/22

Spud 11-18-53

Gas Well

TD 2625'

8-5/8" @ 646'

Her. 2406', Win 2459', Ft. Riley 2533'

TD 2625'

5" @ 2576'

CO to 2625'

frac 3000 A 84/ 2406-22

24/ 2426-30 48/ 2438-46 104/ 2459-78

60/ 2486-96 48/ 2522-30 66/ 2533-44

72/ 2550-62 frac 12000 A

Comp 10,919,000 gas 385#

COMPLETED

County Hamilton State Kansas

Sec. 29 (Blk. Twp.) 26 (Sur. Rge.) 39W Map No.

Operator **Stanolind**

Well No. **1** Farm **Trussel Gas Unit "D"**

Elev.	Location	SW	SW	NE
-------	----------	----	----	----

0

FIRST REPORT

150 Ft. From S Line NE

150 Ft. From ^W Line Quarter

1st. Report NOV 18 1953

Completion

Remarks

Spudding Date _____

Drlg. Data Hugoton Pool

Location

J. G. McGEHEE

Scout Cards *mm*

Land Small Map

Land Wall Map *5*

Tracings

Plance Map

Blance Map

Misc

NOV 20 1953

Drig. Date

County Hamilton State Kansas

Sec: 29 (Blk. Twp.) 26 (Sur. Rge.) 39W Map No.

Operator Stanolind

Well No. 1 Farm Turssel Gas Unit "D"

Elev.	3300	Location	SW SW NE
-------	------	----------	----------

0

COMPLETE

150 Ft. From S Line NE

150 Ft. From W Line Quarter

1st. Report

Completion DEC 22 1953

Remarks .

Spudding Date 11-18-53

Drlg. Data Gas. well TD 2625

8 5/8" @ 646 Her. 2406 Win. 2459

Ft. Riley 2533 TD 2625 5" @ 2576

CQ to 2625 frac 3000 A 84/ 2406-22

24/ 2426-30 48/ 2438-46 104/ 2459-78

60/ 2486-96 48/ 2522-30 66/ 2533-44

72/ 2550-62 frac: 12000 A

Comp. 10,919,000 gas 385#

J. G. McGEHEE

SEC 29 1953

1958
JAN 10 1958
MISS. ...