

Firney


FORM 51 IOM 12-46 PETROL

ANSAS

Section 29 Township 26 Range 34N

Well No. # Jones

Company Helmerich & Payne

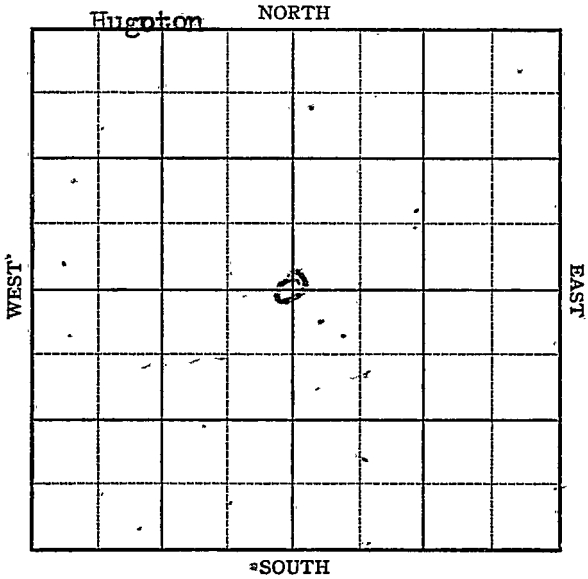

KANSAS Finney County

Sec. 29 Twp. 26 R. 34-WWell No. 4 Jones FarmHelmerich & Payne Company

Hugoton Pool


2640 Ft. from N. Line

Ft. from S. Line

2640 Ft. from E. Line

Ft. from W. Line

C. Sec.

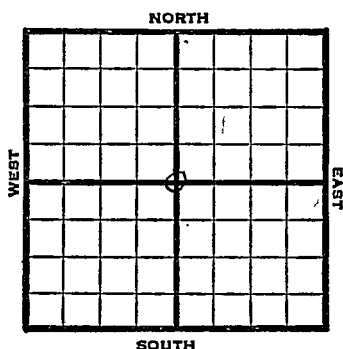

1947 Elev. - REPORT


7/30	RUR
8/6	10" @ 800' Dr1g 850'
8/13	7" @ 2483 TD
8/20	" "
8/27	TD 2483'
9/3	"
9/10	TD 2740' 15000 Acid
9/17	7" @ 2483' 277' of 5" Perf liner @ 2740 17,000Acid 31,279,000 Gas 410# Rock Pressure Total Depth 2740' COMPLETED

12112228

Map No. _____ Sec. 29 Twp. 26 R. 34WWell No. 4 JonesHelmerich & Payne CompanyFIRST REPORT Contractor

C Sec.

SECTION PLAT

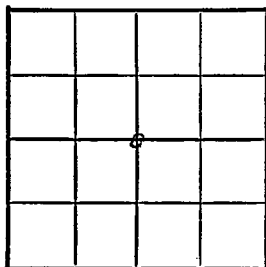2640 Ft. from N. Line

_____ Ft. from S. Line

2640 Ft. from E. Line

_____ Ft. from W. Line

Finney County

Location _____

Rig up _____

Drilling and Remarks:

R U R

RECORD

Cased _____ in., _____ ft.

Sand _____

Gas _____

Oil _____

Total Depth _____

PRODUCTION

1st 24 hrs. Nat. _____

1st 24 hrs. after shot _____

Gas _____ Cu. Ft.

Dry Hole _____

Abandoned _____

Date

JUL 30 1947

19

S. J. LEWIS

Scout

Map No. 0 Sec. 29 Twp. 26 R. 34W

Well No. 4 Jones

Helmerich & Payne Company

COMPLETE

Contractor

C Sec.


SECTION PLAT

2640 Ft. from N. Line

_____ Ft. from S. Line

2640 Ft. from E. Line

_____ Ft. from W. Line

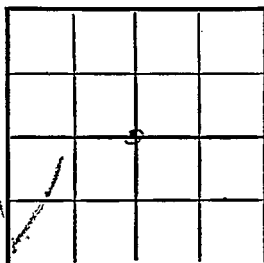

Finney County

Location _____

Rig up _____

Drilling and Remarks:

7" @ 2483

277' of 5" Prof

lost @ 2740

17000' Prod

31,279,000 Gas

410# R/P

RECORD

Cased _____ in, _____ ft.

Sand _____

Gas _____

Oil _____

Total Depth 2740

PRODUCTION

1st 24 hrs. Nat. _____

1st 24 hrs. after shot _____

Gas _____ Cu. Ft.

Dry Hole _____

Abandoned _____

Date

SEP 17 1947

19

S. J. LEWIS Scout