


Sedgwick

KANSAS

SECTION 2 TOWNSHIP 26 RANGE 3W

WELL NO. #1 Venjohn

COMPANY I. W. Siegle et al

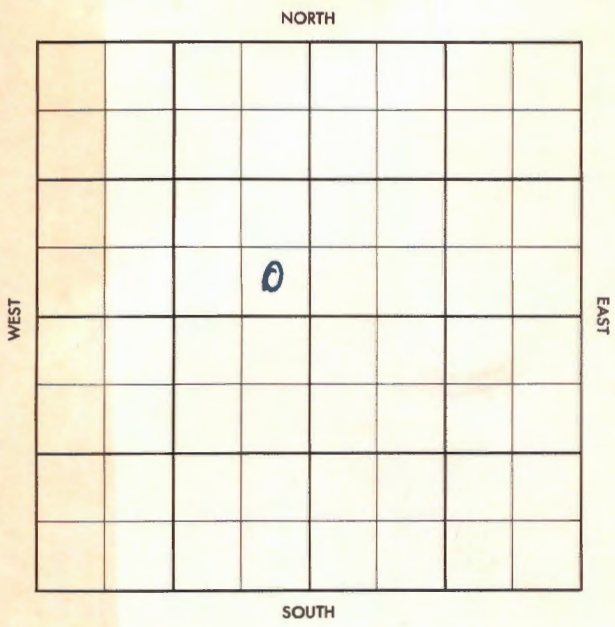

SEC. 2	TWP. 26	R. 3W
-----------	------------	----------

WELL NO. #1 Venjohn FARM

COMPANY I.W. Siegle etal

CONTRACTOR Sterling


WILDCAT

_____ Ft. from N. Line

_____ Ft. from S. Line

_____ Ft. from E. Line

_____ Ft. from W. Line

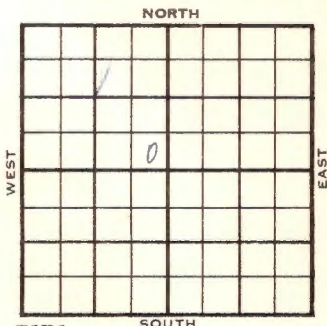

SE SE NW

Atl. DHM
Champ. FO & DHM

1956	ELEVATION 1415'	REPORT
------	---------------------------	--------

4-18 Comm. 4-14-56
~~###~~ Lost circ. @ 300

5-9 Comm. 4-14-56
13" @ 162 w/250
8 5/8", @ 504 w/225
DST 3036-55 op 30 min. rec. 12' mud,
BHP 1125/10".
DST 3072-3102 op 1 hr. rec. 465' mw
FP 0-270#. BHP 1350/20".
DST 4075-4105 op 1 hr. rec. 3180', SW,
BHP 1560/20".

D & A

H. 2416'

KC. 2646 2642

M. 3488 3488

K. 3853 3802

Mq. 3915 3913

V. 3952 3949

S.Dolo 3965

S.Sd 3976 3975

A. 4072 4069

TD 4105'

ABANDONED

County Sedgwick Elev. _____
 Sec. 2 Twp. 26 Rgs. 3W
 Company I. W. Siegle et al.
 Farm Name Venjohn No. 1

TOPS	DEPTH	LOG	DATUM	Loc. in Sec.
Anb.				SE SE NW
Tp.				
H.				
Tr.				
Dg.				
Bl.				
L.				Geol. _____
K.C.				Contr. _____
B.K.C.				
Ce.				<u>Sterling</u>
C.				
M.				Pool _____
M.				<u>Wildcat</u>
K.				
Mz.				
Me.				
V.				
S.				
S.				
A.				
R.				
PE.				
G.				
TD.				

FIRST REPORT
 APR 18 1956

Date Comm. 1-11-56 ^{ATI} ^{DHM}
 Champ. FO & DHM
lost circ. @ 300

APR 5 4 1956

R. G.

(Handwritten scribble)

Co.
Lse.
No.
Sec.
T.
R.

County Sedgwick Elev. 1415
 Sec. 2 Twp. 26 Rgn. 3W
 Company I. W. Siegle et al.
 Farm Name Venjohn No. 1

Co.

TOPS	DEPTH	LOG	DATUM
Anh.			
TP.			
H.	2416		
Tr.			
Dg.			
Bl.			
L.			
K.C.	2646	2642	
B.K.C.			
Ce.			
C.			
M.	3487	3488	
M.			
K.	3853	3802	
M.			
Mo.	3915	3913	
V.	3952	3949	
S. <u>Dolo</u>	3965		
S. <u>sd</u>	3976	3975	
A.	4072	4069	
R.			
PE.			
G.			
TD.	4105		

Loc. in Sec. SE SE NW

Geol. _____
 Contr. Sterling

Pool Wildcat

MAY	9	1956
o		

ABANDONED

Loc.

No.

Sec.

T.

R.

Date Comm. 1-11-56 13" @ 162/250
 lost circ. 300 APR 25 '55

8 5/8 504/225 @ 2235 MAY 2 '56
DST 3036-55 30" rec 12' MD
BHP 1125/110" DST 3072-3102
1hr 465' MW FPO-270 BHP
1350/20 @ 3580 MAY 9 '58 DST 4075
-4105 1hr rec 3180' SW BHP 1560
120"

D&A.