


Section 3 Township 26 Range 39W

Well No. #2 Brothers

Company United Prod.

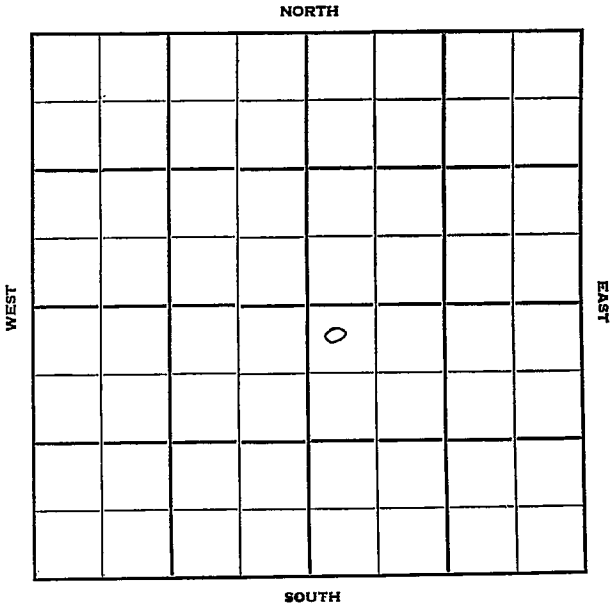

Sec. 3 Twp. 26 R. 39 W

Well No. # 2 Brothers Farm

United Prod. Company

Contractor


450 Ft. from N. Line

Ft. from S. Line

Ft. from E. Line

150 Ft. from W. Line

NW SE

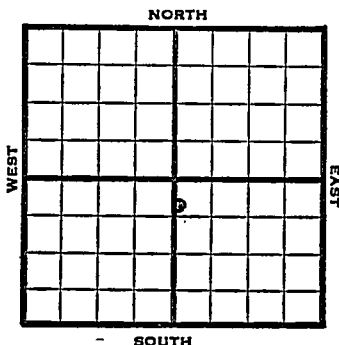

1952

REPORT

1/9 Spud 1-7-52  
Drlg. 312'

2/6 TD 2587 7" @ 2483 4000A

2/13 Her 2479 Krider 2507  
1000 A

2/20 Fishing

3/5 3,040,000 gas Waiting on state test

3/12 2000 A

3/19 NR

4/2 Spud 1-7-52  
Gas Well TD 2587  
10" @ 435 7" @ 2483 TD 2587  
Her. 2479 Kri 2507  
PB 2585 16000 A  
Comp. 335,000 gas

**COMPLETED**



